


Inventor: Takahiro Naka, et al.
For: LIQUID CONTAINER
Appln. No.: Not Yet Assigned
Filing Date: Concurrently Herewith (3/26/04)
Atty. Docket: 448563/0245
Sheet No. 1 of 37

STROOCK & STROOCK & LAVAN, LLP
180 Maiden Lane
New York, New York 10038
(212) 806-5400


FIG. 1

Fig. 1


(A)

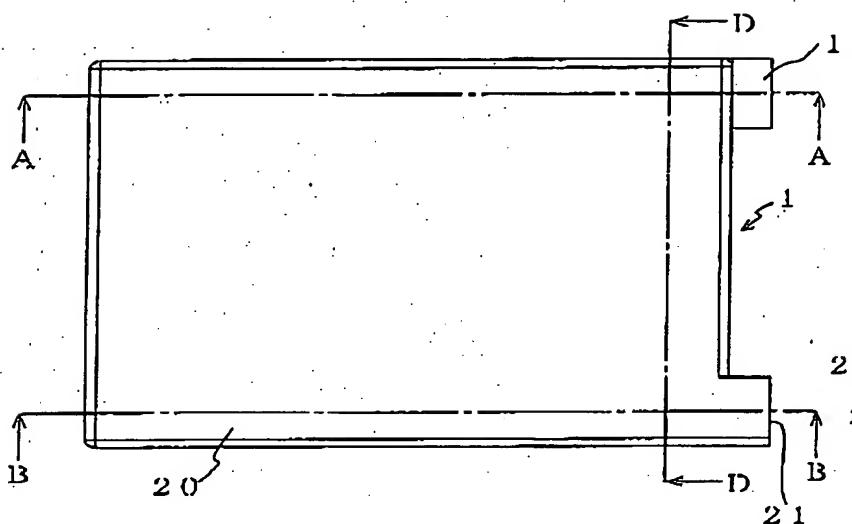

(B)

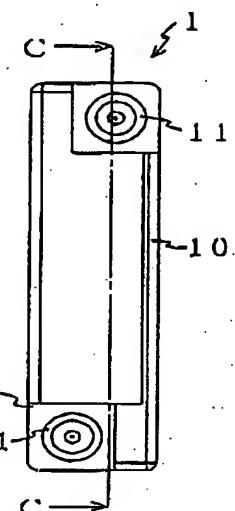


(C)

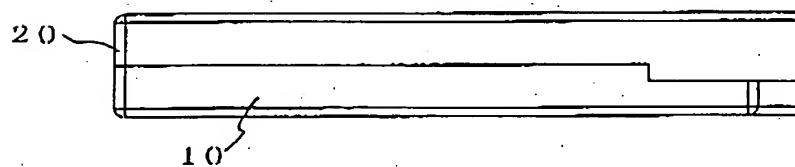

Inventor: Takahiro Naka, et al.
For: LIQUID CONTAINER
Appln. No.: Not Yet Assigned
Filing Date: Concurrently Herewith (3/26/04)
Atty. Docket: 448563/0245
Sheet No. 2 of 37

STROOCK & STROOCK & LAVAN, LLP
180 Maiden Lane
New York, New York 10038
(212) 806-5400



[图2] Fig. 2

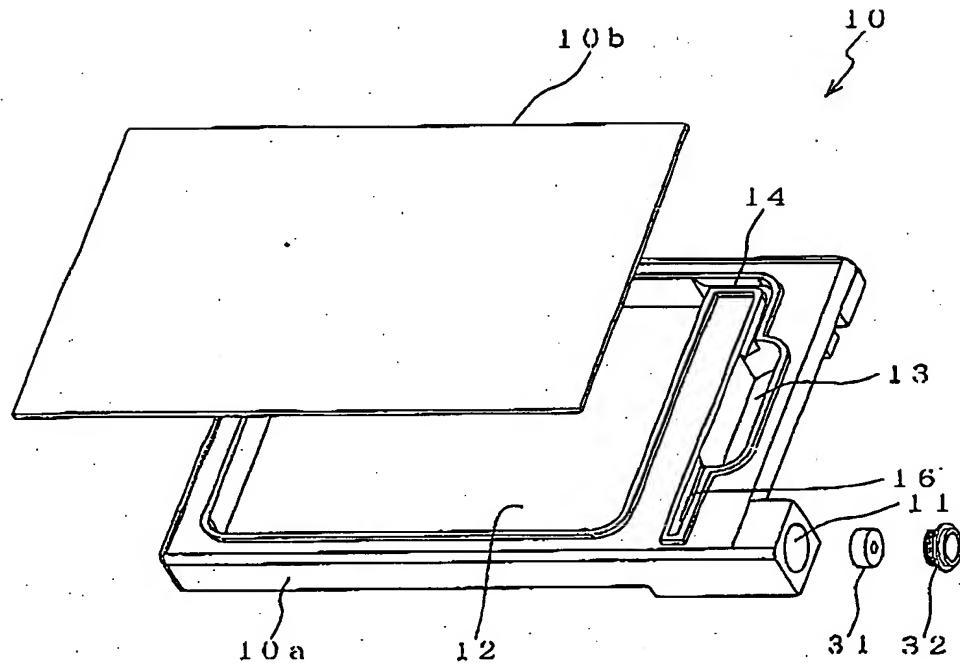

Inventor: Takahiro Naka, et al.
For: LIQUID CONTAINER
Appln. No.: Not Yet Assigned
Filing Date: Concurrently Herewith (3/26/04)
Atty. Docket: 448563/0245
Sheet No. 3 of 37

STROOCK & STROOCK & LAVAN, LLP
180 Maiden Lane
New York, New York 10038
(212) 806-5400


~~FIG. 3~~ Fig. 3

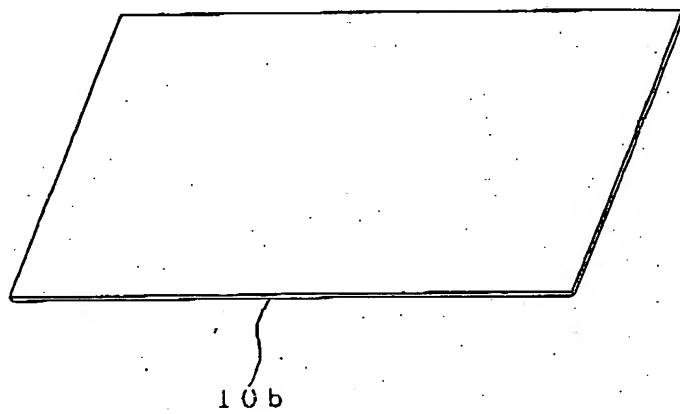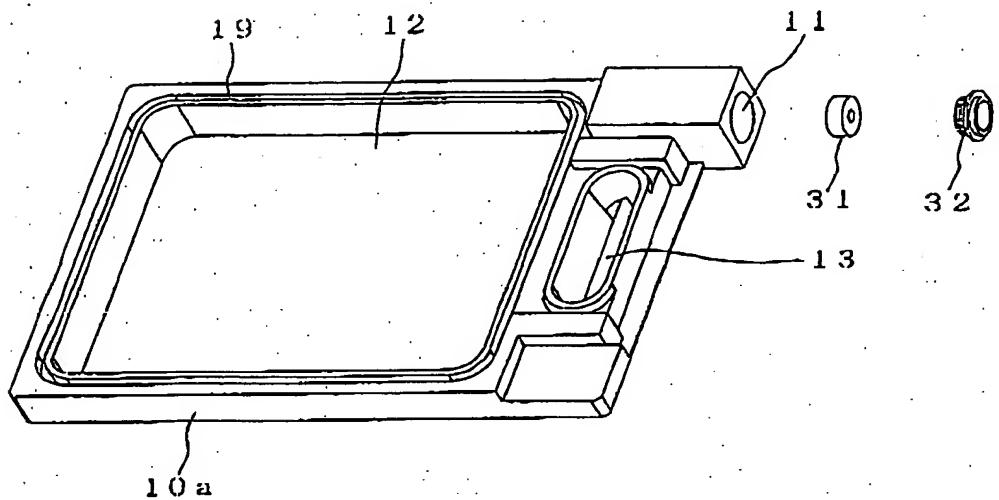


Inventor: Takahiro Naka, et al.
For: LIQUID CONTAINER
Appln. No.: Not Yet Assigned
Filing Date: Concurrently Herewith (3/26/04)
Atty. Docket: 448563/0245
Sheet No. 4 of 37

STROOCK & STROOCK & LAVAN, LLP
180 Maiden Lane
New York, New York 10038
(212) 806-5400

【图4】 7+g.4

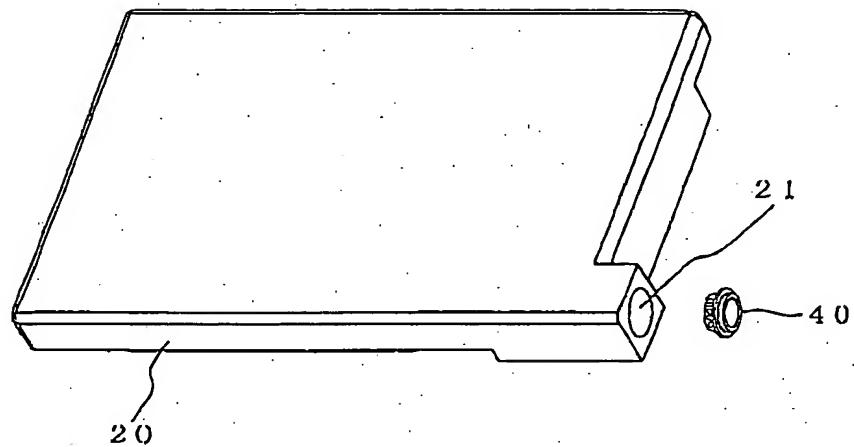


【图5】 7+g.5

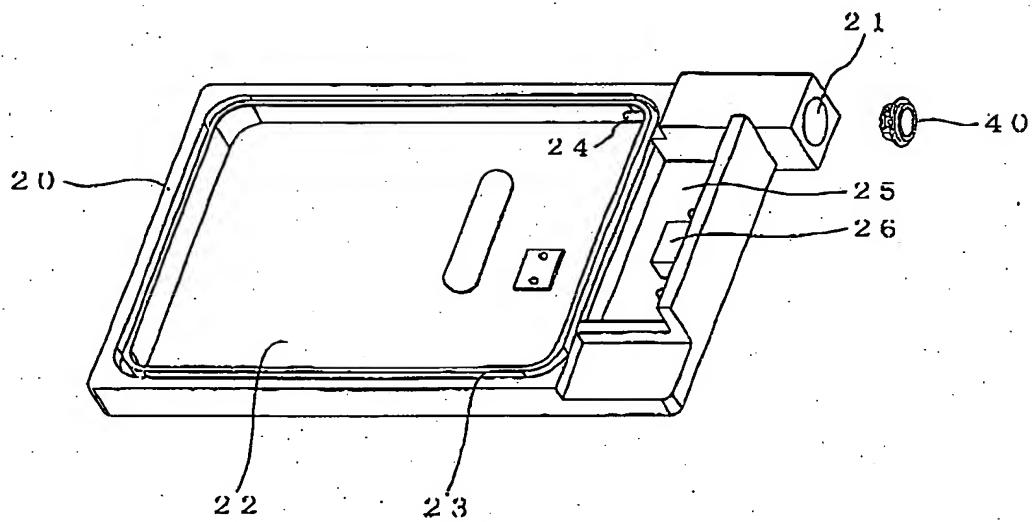

Inventor: Takahiro Naka, et al.
For: LIQUID CONTAINER
Appln. No.: Not Yet Assigned
Filing Date: Concurrently Herewith (3/26/04)
Atty. Docket: 448563/0245
Sheet No. 5 of 37

STROOCK & STROOCK & LAVAN, LLP
180 Maiden Lane
New York, New York 10038
(212) 806-5400


[REDACTED] Fig. 6

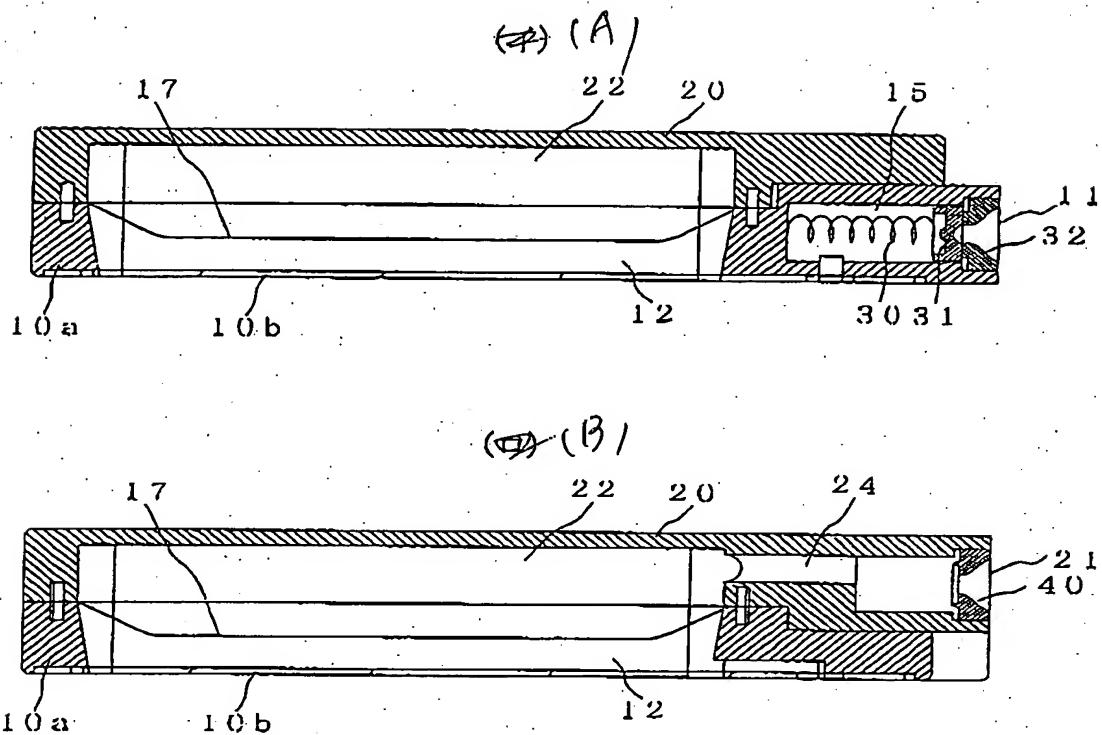


Inventor: Takahiro Naka, et al.
For: LIQUID CONTAINER
Appln. No.: Not Yet Assigned
Filing Date: Concurrently Herewith (3/26/04)
Atty. Docket: 448563/0245
Sheet No. 6 of 37

STROOCK & STROOCK & LAVAN, LLP
180 Maiden Lane
New York, New York 10038
(212) 806-5400

[] Fig. 7

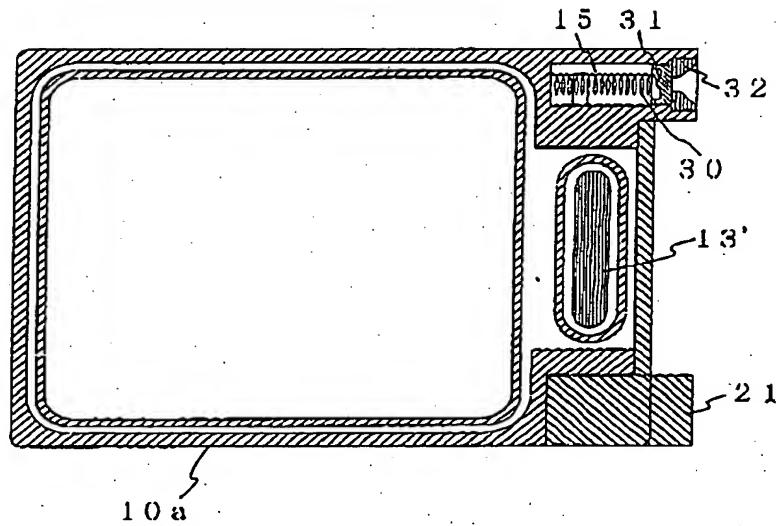


[] Fig. 8

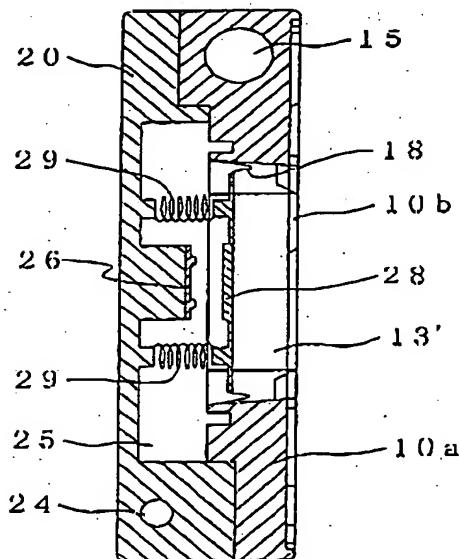

Inventor: Takahiro Naka, et al.
For: LIQUID CONTAINER
Appln. No.: Not Yet Assigned
Filing Date: Concurrently Herewith (3/26/04)
Atty. Docket: 448563/0245
Sheet No. 7 of 37

STROOCK & STROOCK & LAVAN, LLP
180 Maiden Lane
New York, New York 10038
(212) 806-5400



[REDACTED] 7-2-9

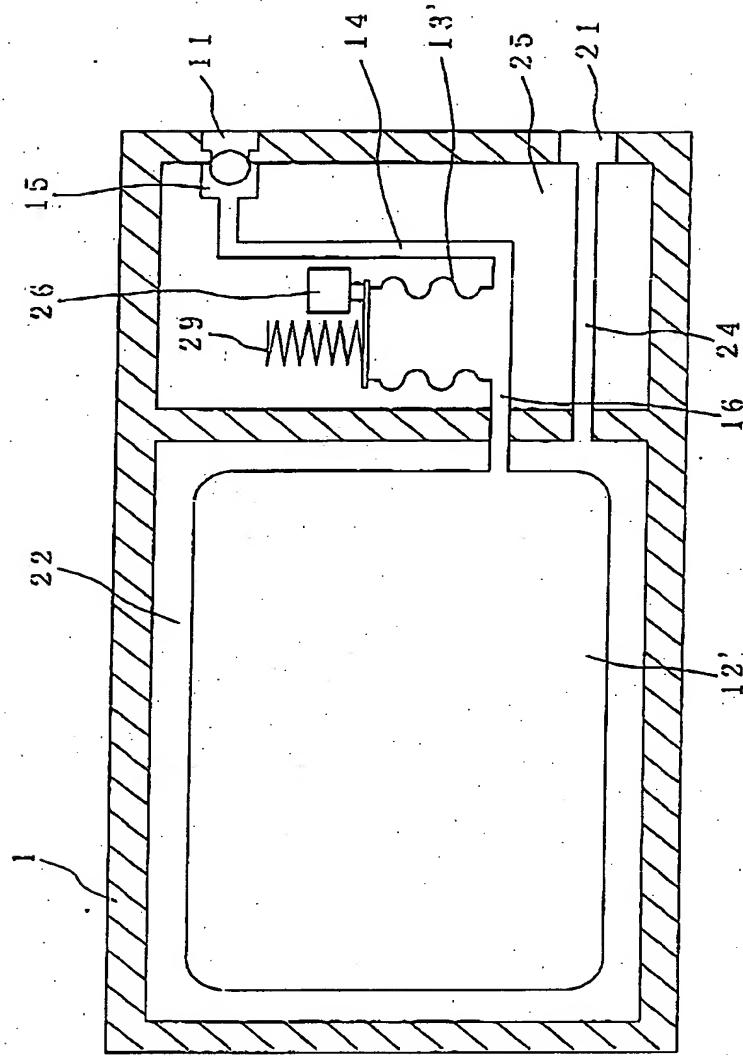

Inventor: Takahiro Naka, et al.
For: LIQUID CONTAINER
Appln. No.: Not Yet Assigned
Filing Date: Concurrently Herewith (3/26/04)
Atty. Docket: 448563/0245
Sheet No. 8 of 37

STROOCK & STROOCK & LAVAN, LLP
180 Maiden Lane
New York, New York 10038
(212) 806-5400

[REDACTED] Fig. 10

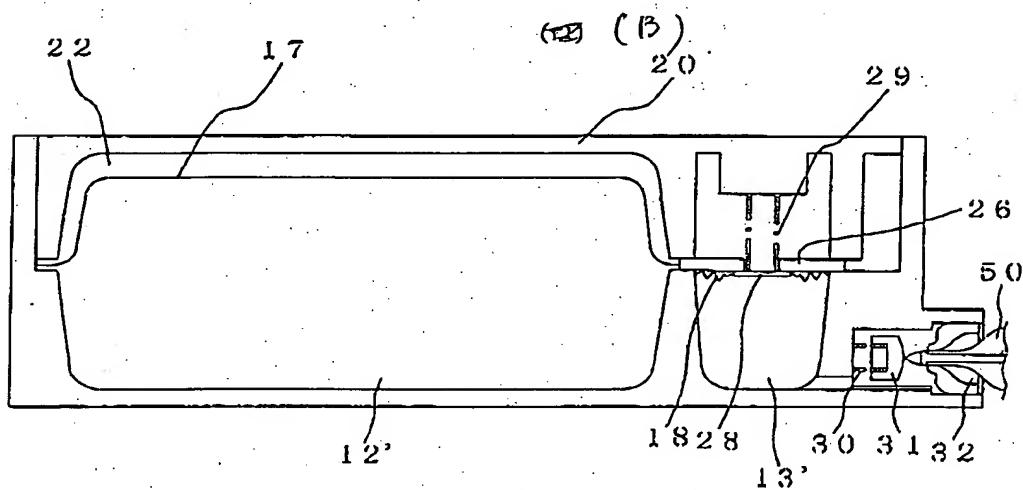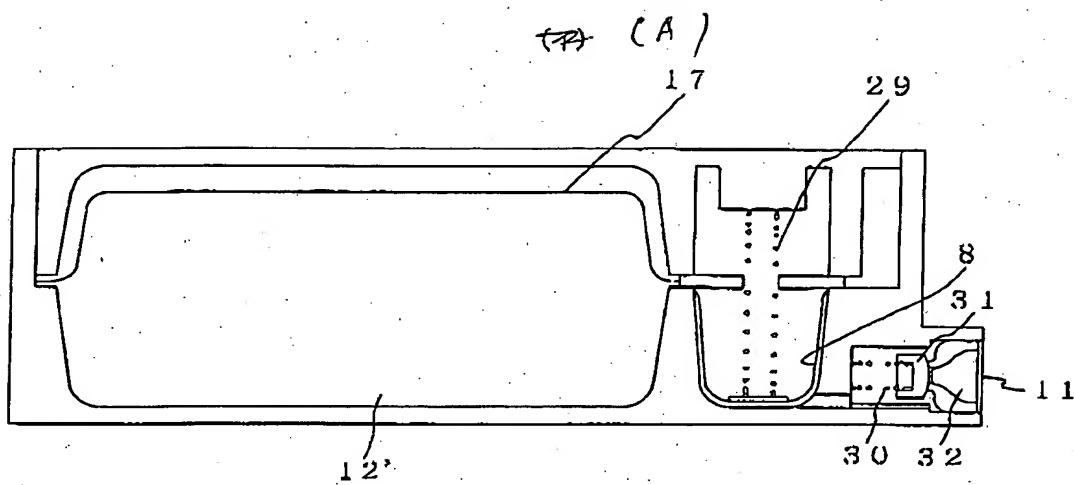


Inventor: Takahiro Naka, et al.
For: LIQUID CONTAINER
Appln. No.: Not Yet Assigned
Filing Date: Concurrently Herewith (3/26/04)
Atty. Docket: 448563/0245
Sheet No. 9 of 37


STROOCK & STROOCK & LAVAN, LLP
180 Maiden Lane
New York, New York 10038
(212) 806-5400

[Fig. 11] Fig. 11

(A)

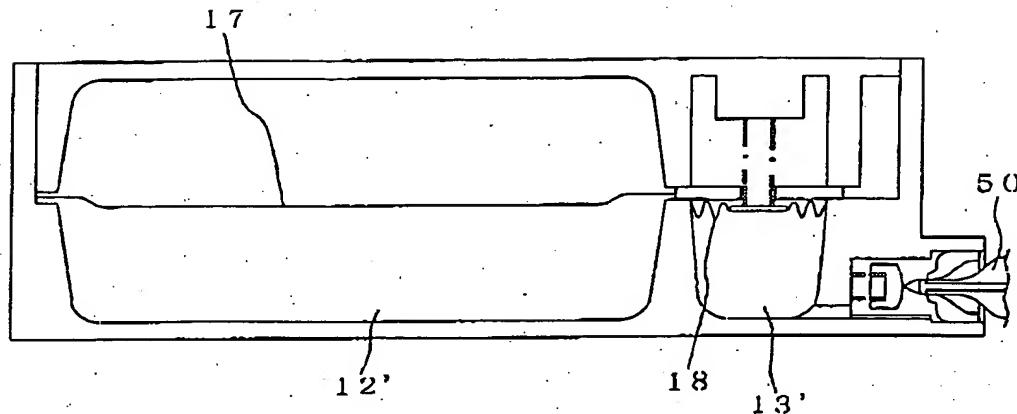

(B)

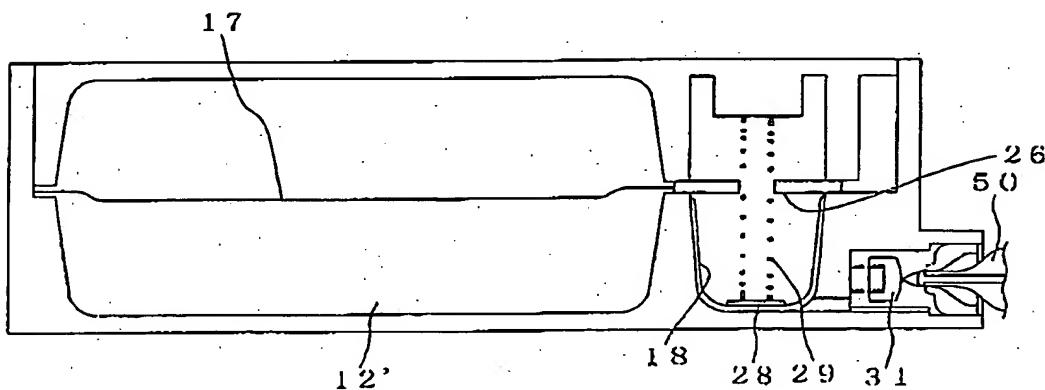


Inventor: Takahiro Naka, et al.
For: LIQUID CONTAINER
Appln. No.: Not Yet Assigned
Filing Date: Concurrently Herewith (3/26/04)
Atty. Docket: 448563/0245
Sheet No. 10 of 37


STROOCK & STROOCK & LAVAN, LLP
180 Maiden Lane
New York, New York 10038
(212) 806-5400

[图12] 7-2-12

(A)

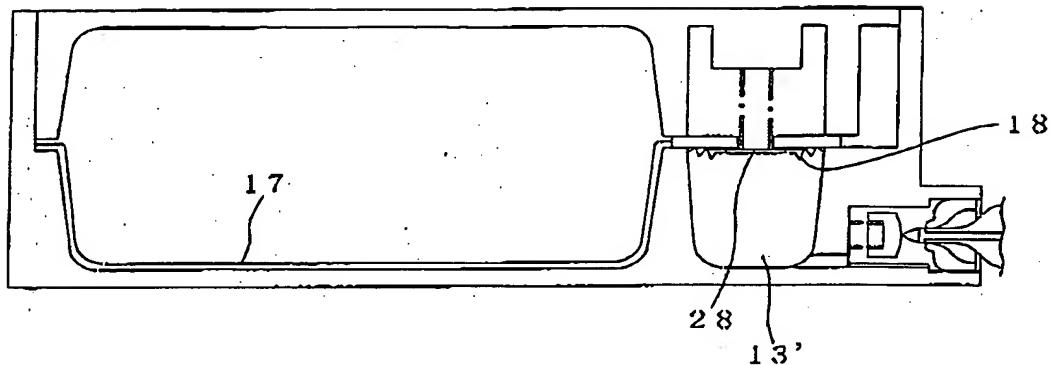


(B)

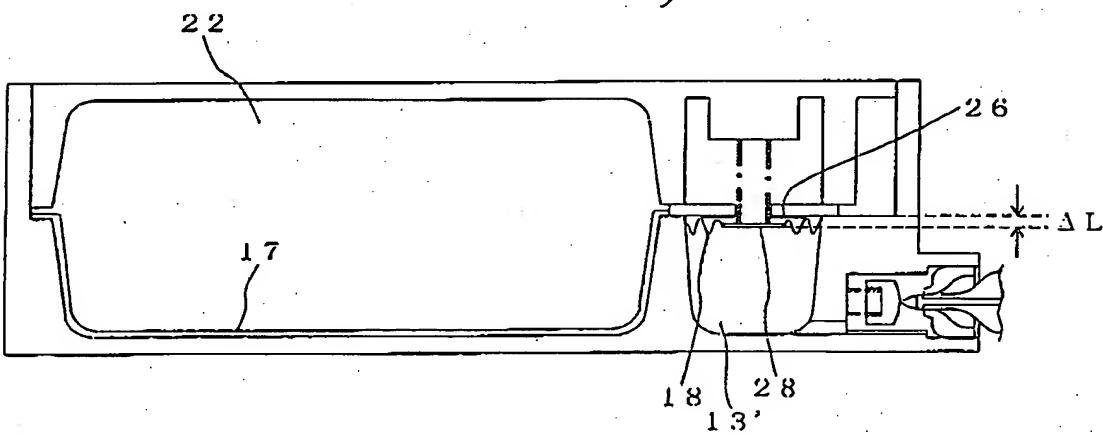


Inventor: Takahiro Naka, et al.
For: LIQUID CONTAINER
Appln. No.: Not Yet Assigned
Filing Date: Concurrently Herewith (3/26/04)
Atty. Docket: 448563/0245
Sheet No. 11 of 37

STROOCK & STROOCK & LAVAN, LLP
180 Maiden Lane
New York, New York 10038
(212) 806-5400

【図13】 27.13

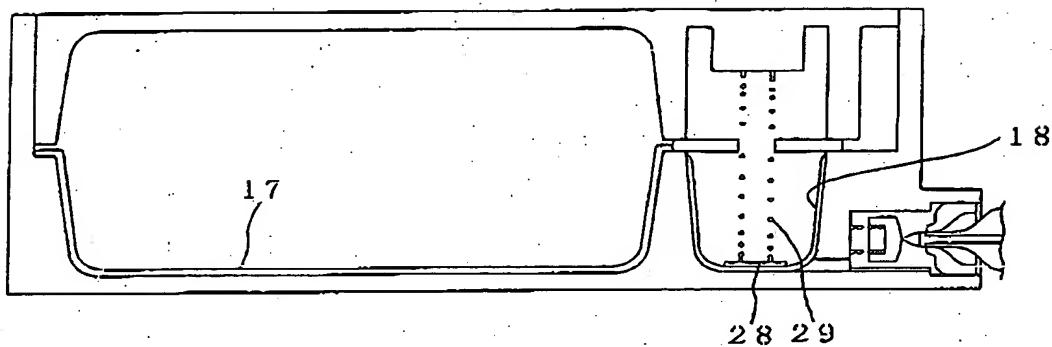


【図14】 27.14

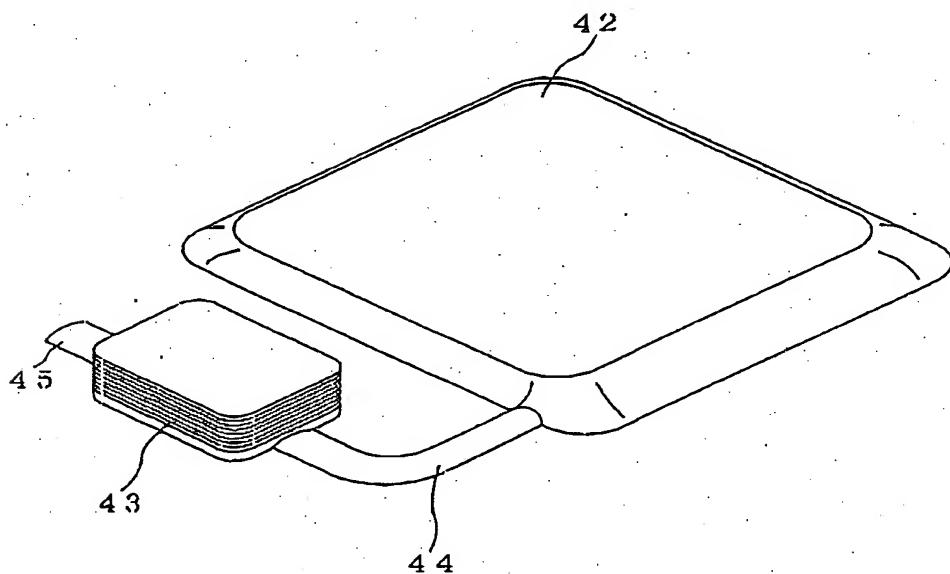


Inventor: Takahiro Naka, et al.
For: LIQUID CONTAINER
Appln. No.: Not Yet Assigned
Filing Date: Concurrently Herewith (3/26/04)
Atty. Docket: 448563/0245
Sheet No. 12 of 37

STROOCK & STROOCK & LAVAN, LLP
180 Maiden Lane
New York, New York 10038
(212) 806-5400

【図15】 119.15

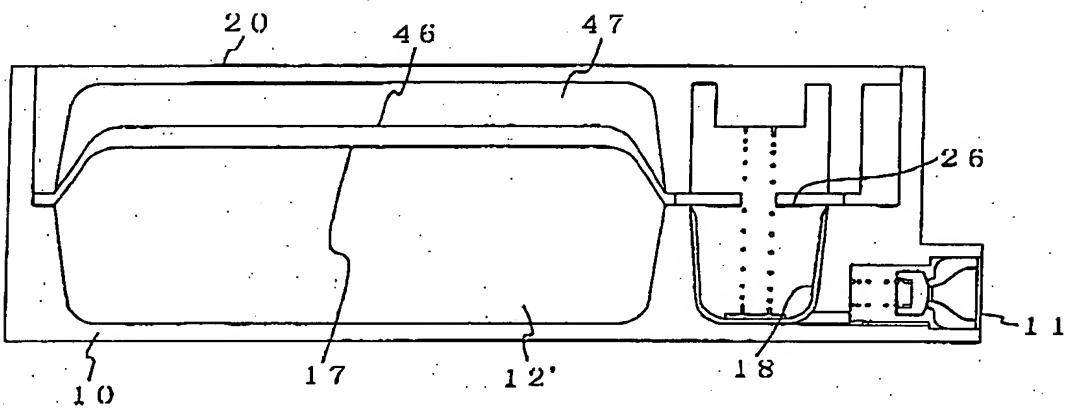


【図16】 219.16

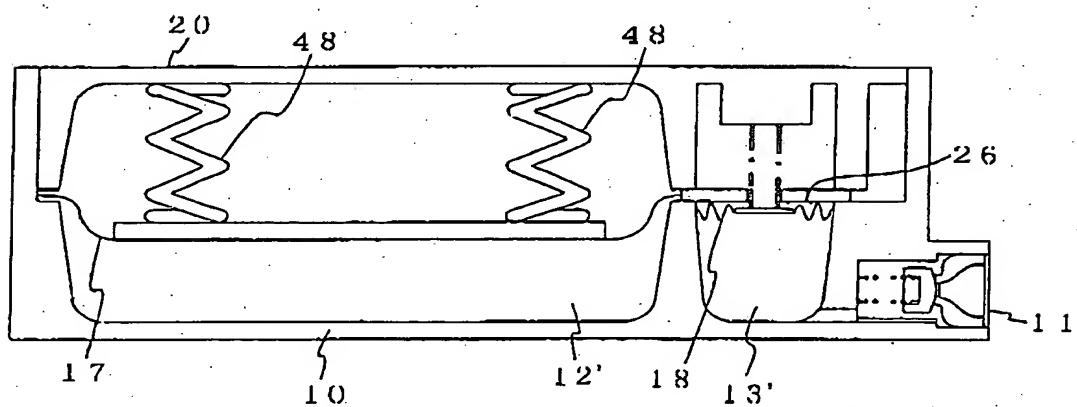

Inventor: Takahiro Naka, et al.
For: LIQUID CONTAINER
Appln. No.: Not Yet Assigned
Filing Date: Concurrently Herewith (3/26/04)
Atty. Docket: 448563/0245
Sheet No. 13 of 37

STROOCK & STROOCK & LAVAN, LLP
180 Maiden Lane
New York, New York 10038
(212) 806-5400

~~117-17~~ 117-17

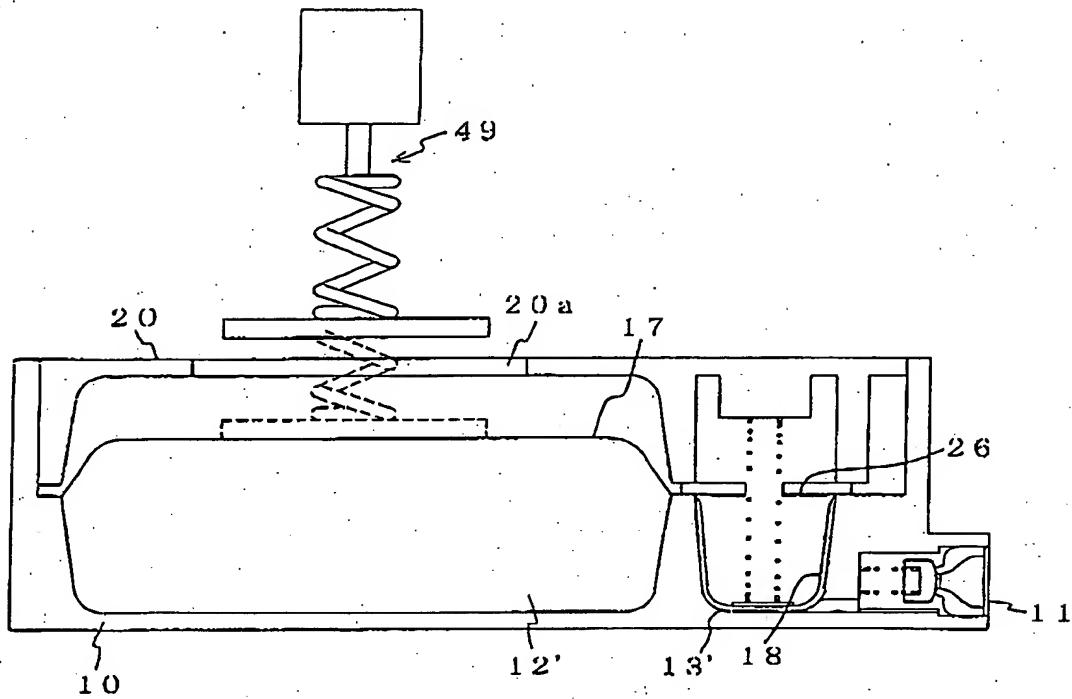

Inventor: Takahiro Naka, et al.
For: LIQUID CONTAINER
Appln. No.: Not Yet Assigned
Filing Date: Concurrently Herewith (3/26/04)
Atty. Docket: 448563/0245
Sheet No. 14 of 37

STROOCK & STROOCK & LAVAN, LLP
180 Maiden Lane
New York, New York 10038
(212) 806-5400

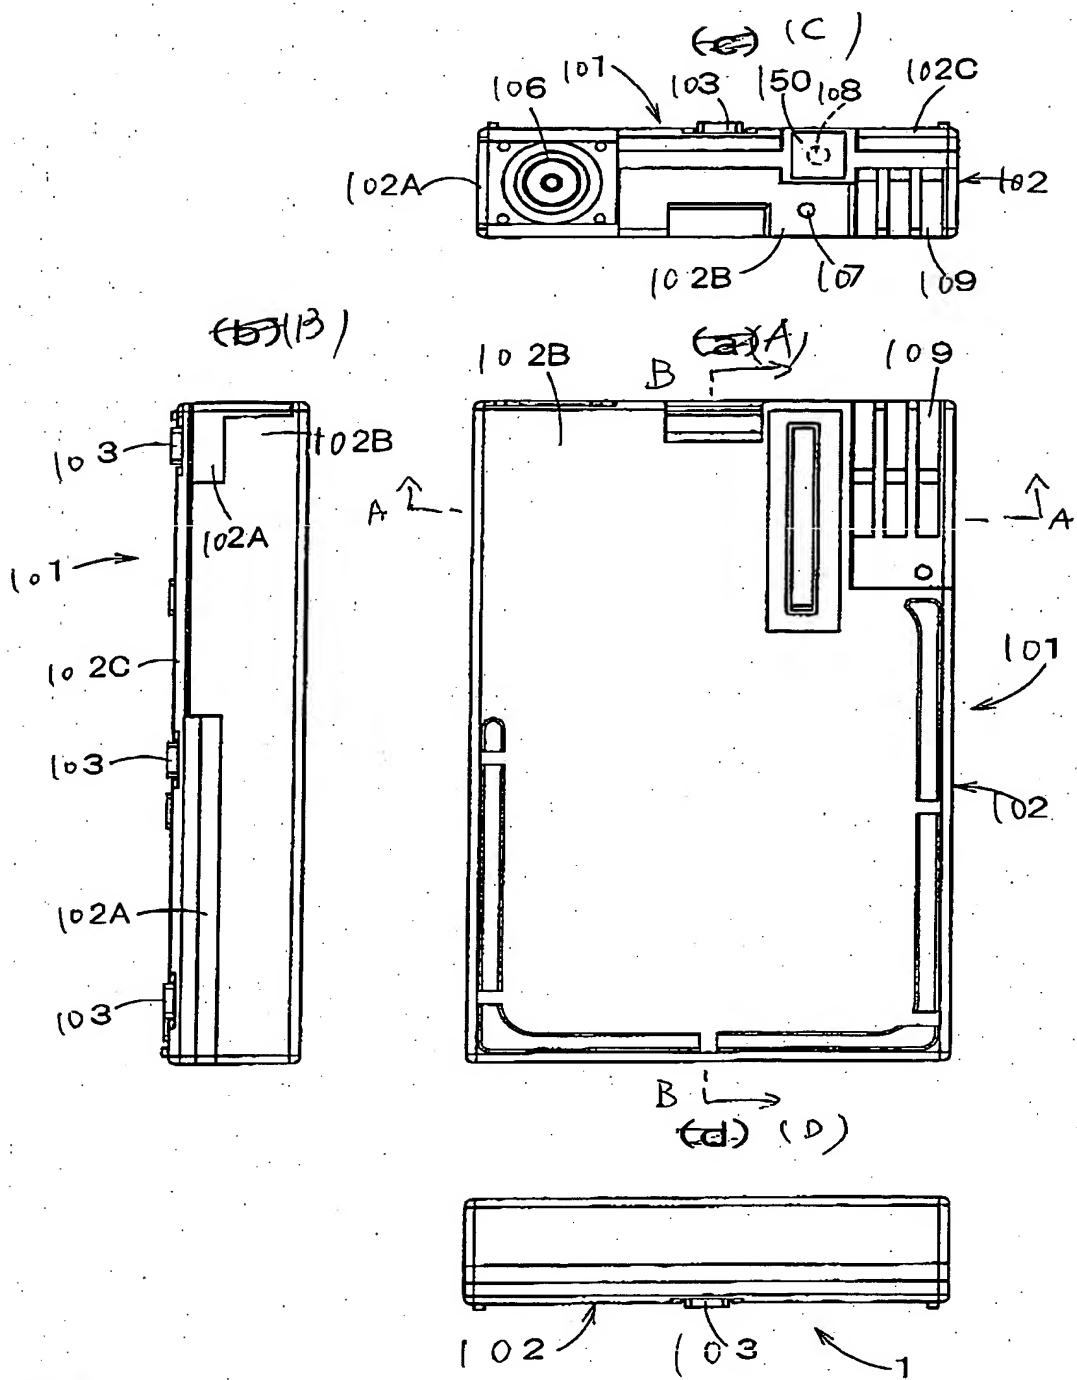



Fig. 18

Inventor: Takahiro Naka, et al.
For: LIQUID CONTAINER
Appn. No.: Not Yet Assigned
Filing Date: Concurrently Herewith (3/26/04)
Atty. Docket: 448563/0245
Sheet No. 15 of 37

STROOCK & STROOCK & LAVAN, LLP
180 Maiden Lane
New York, New York 10038
(212) 806-5400

7-7-19A

7-7-19B

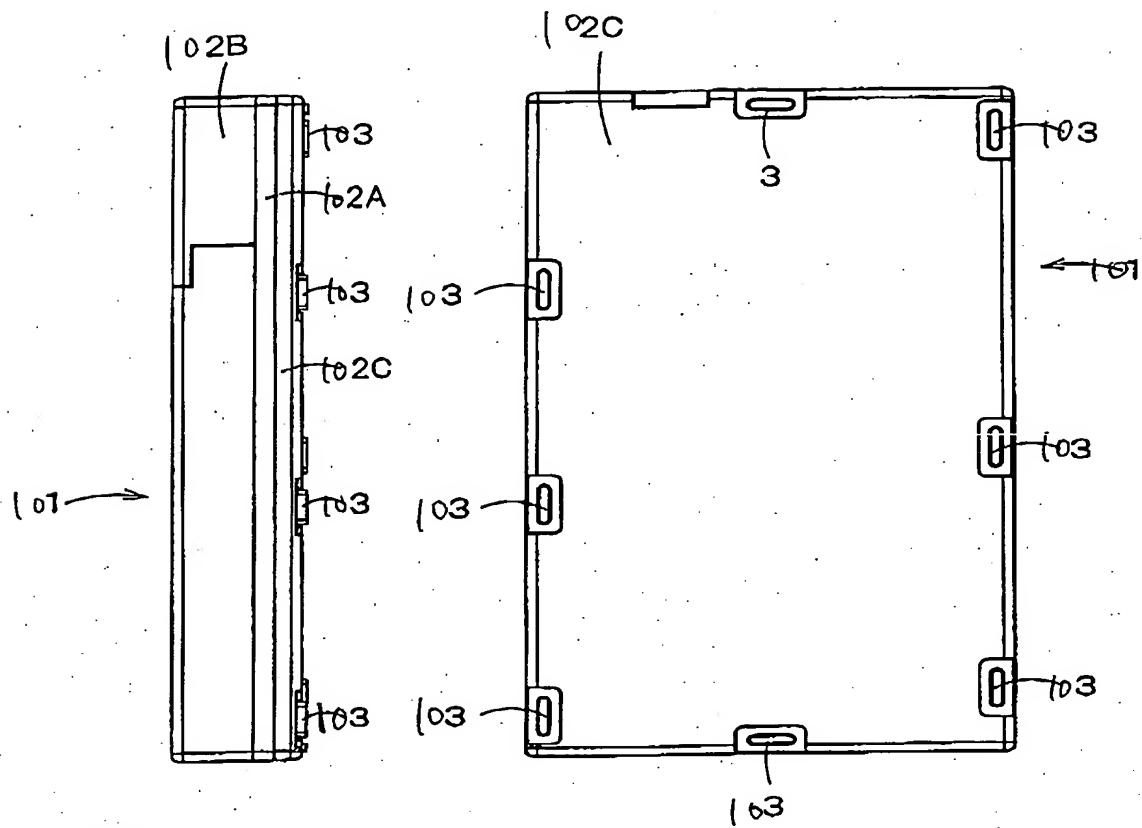


〔図3〕

Frg. 19

Inventor: Takahiro Naka, et al.
For: LIQUID CONTAINER
Appln. No.: Not Yet Assigned
Filing Date: Concurrently Herewith (3/26/04)
Atty. Docket: 448563/0245
Sheet No. 16 of 37

STROOCK & STROOCK & LAVAN, LLP
180 Maiden Lane
New York, New York 10038
(212) 806-5400

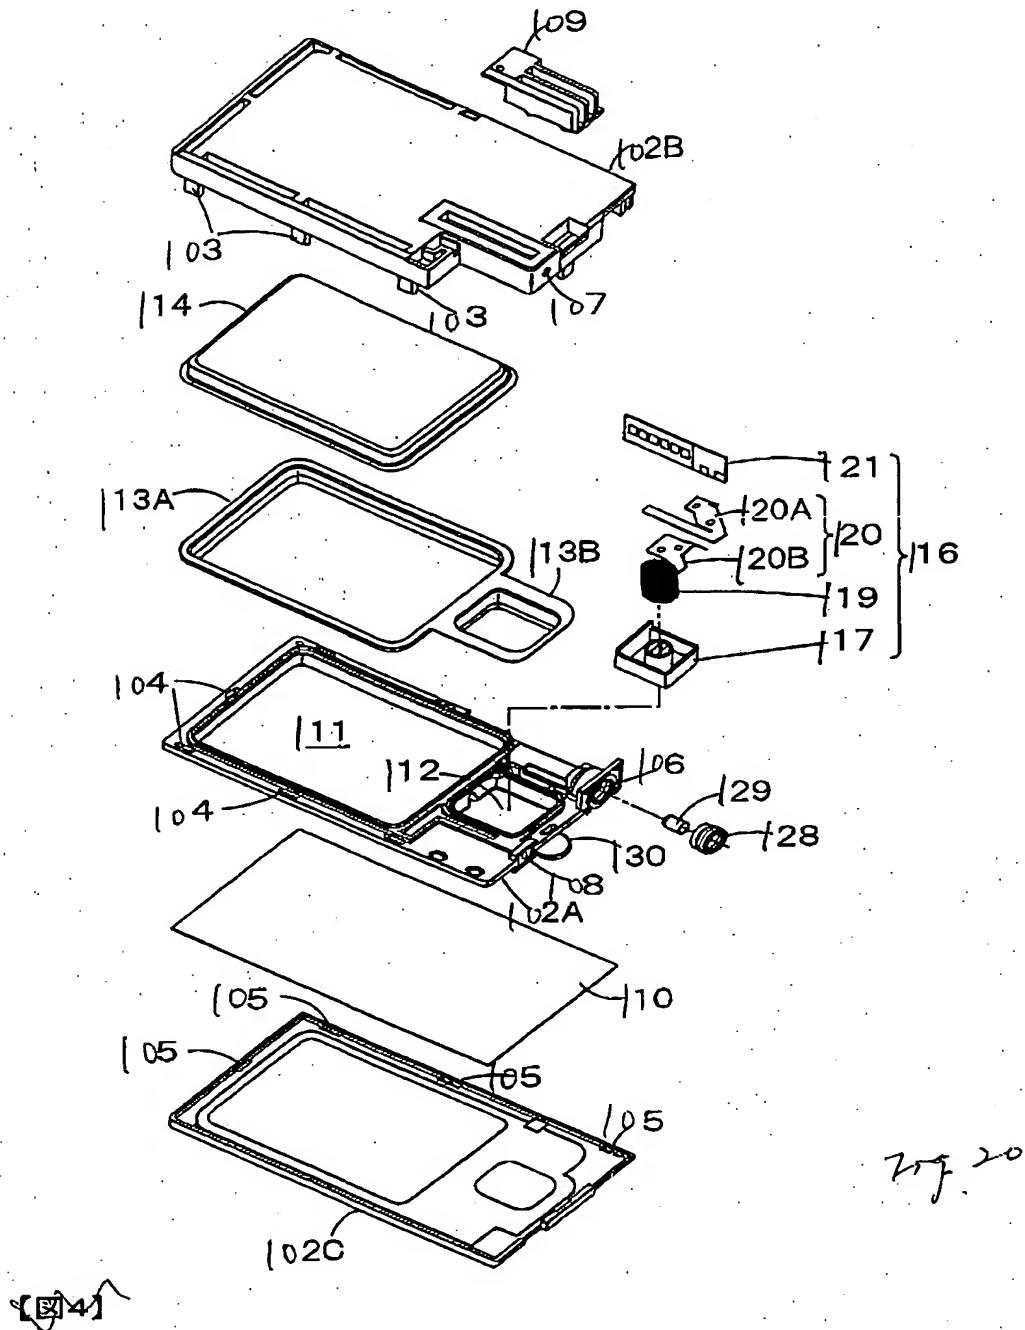

Inventor: Takahiro Naka, et al.
For: LIQUID CONTAINER
Appln. No.: Not Yet Assigned
Filing Date: Concurrently Herewith (3/26/04)
Atty. Docket: 448563/0245
Sheet No. 17 of 37

STROOCK & STROOCK & LAVAN, LLP
180 Maiden Lane
New York, New York 10038
(212) 806-5400

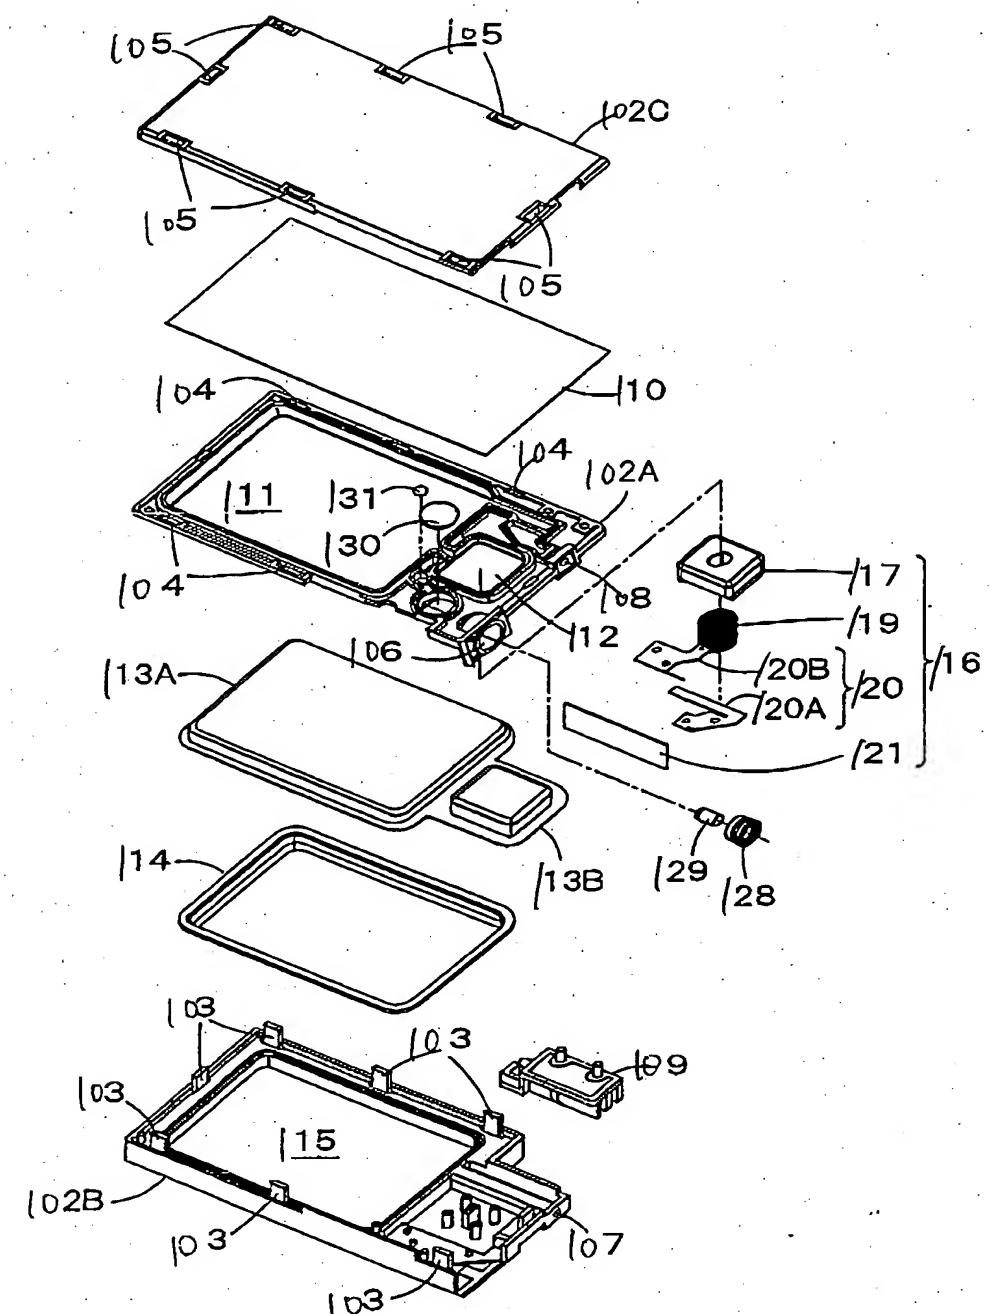


Fig. 21



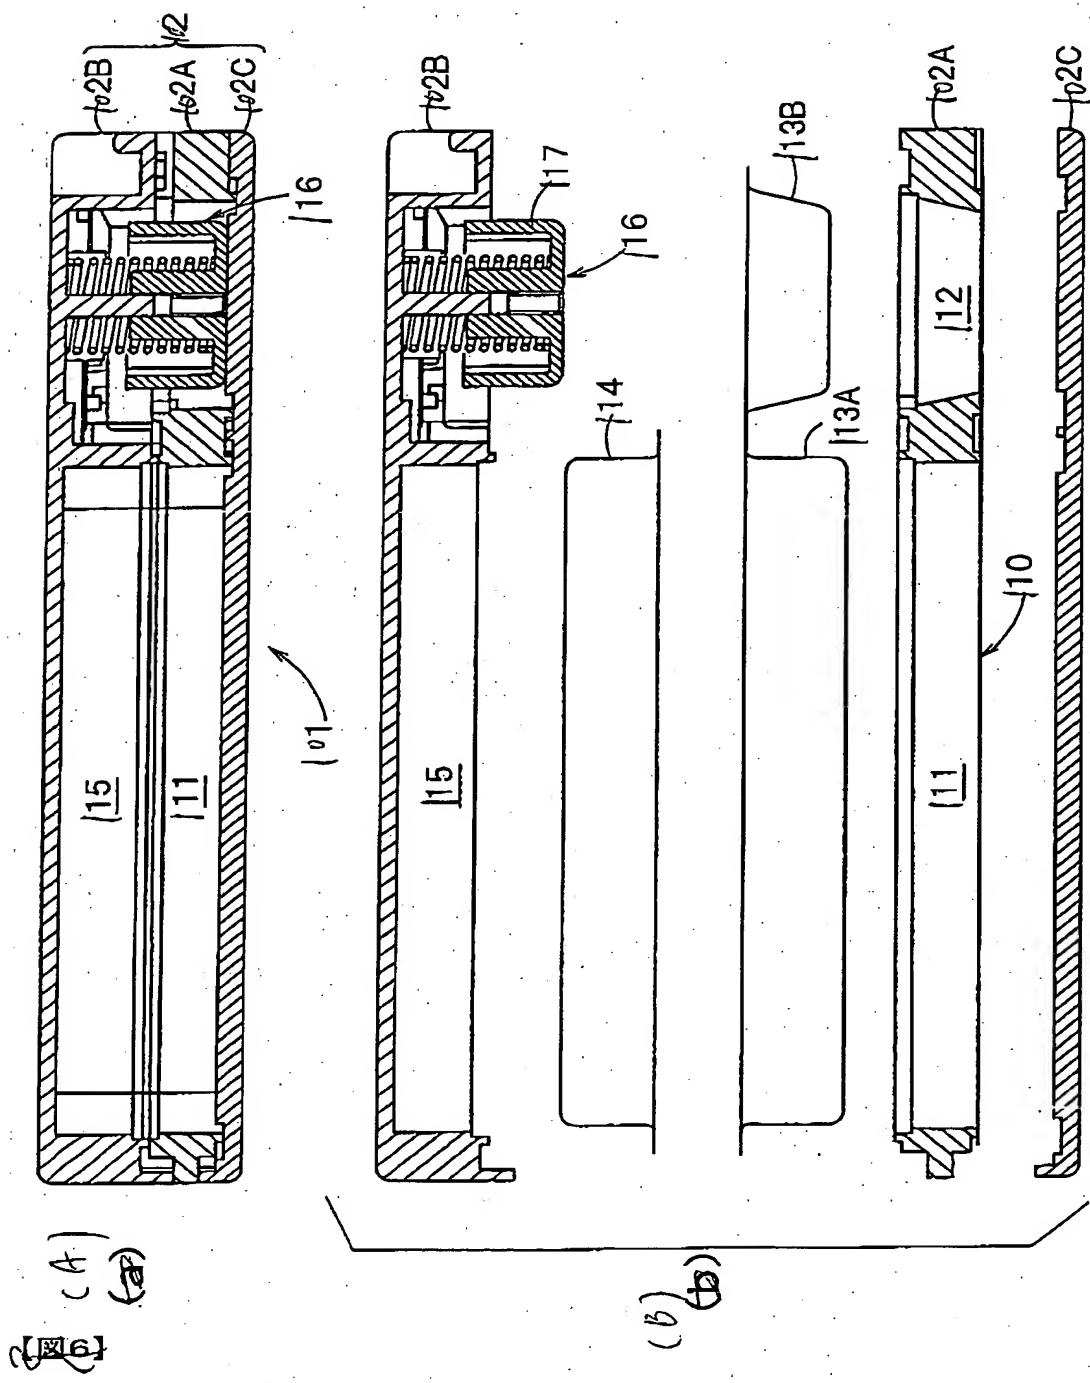


Fig. 22

Inventor: Takahiro Naka, et al.
For: LIQUID CONTAINER
Appln. No.: Not Yet Assigned
Filing Date: Concurrently Herewith (3/26/04)
Atty. Docket: 448563/0245
Sheet No. 19 of 37


STROOCK & STROOCK & LAVAN, LLP
180 Maiden Lane
New York, New York 10038
(212) 806-5400

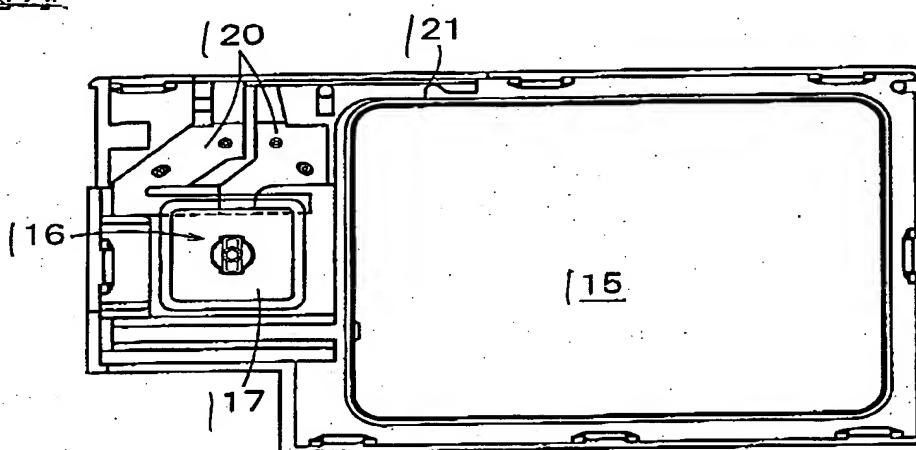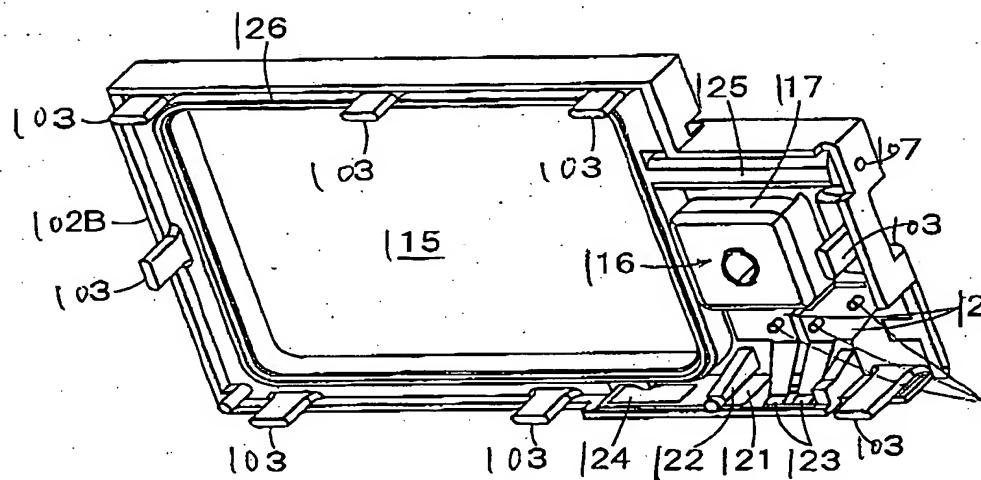




719.24

Inventor: Takahiro Naka, et al.
For: LIQUID CONTAINER
Appn. No.: Not Yet Assigned
Filing Date: Concurrently Herewith (3/26/04)
Atty. Docket: 448563/0245
Sheet No. 20 of 37


STROOCK & STROOCK & LAVAN, LLP
180 Maiden Lane
New York, New York 10038
(212) 806-5400

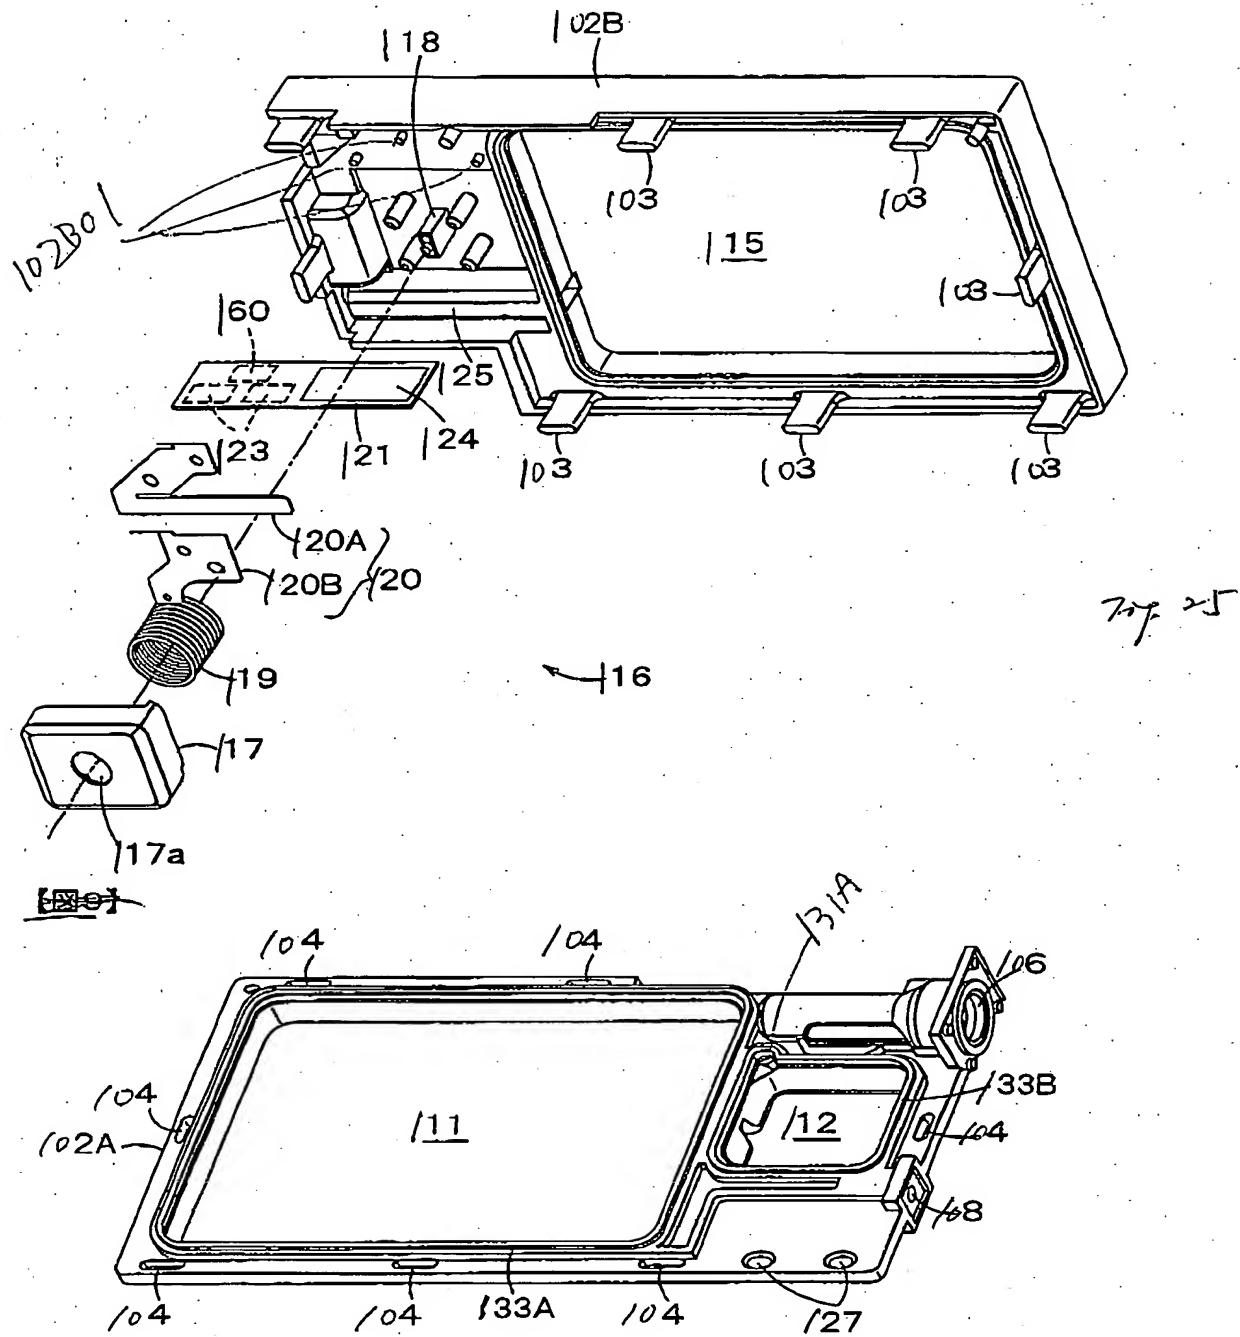




【圖 10】

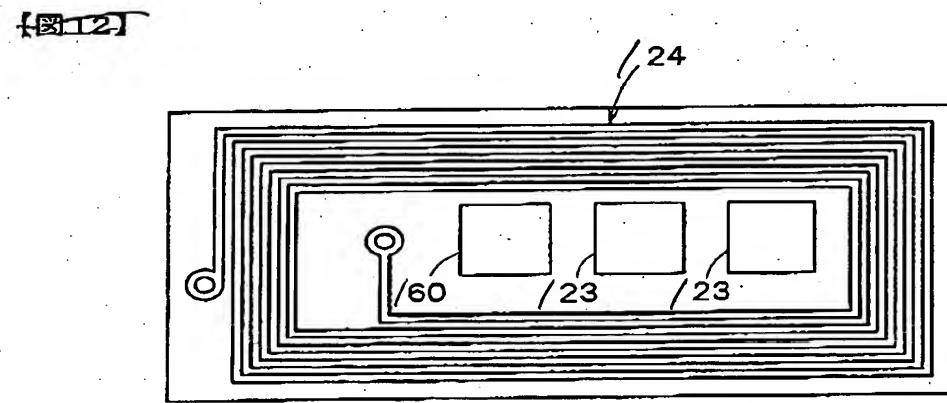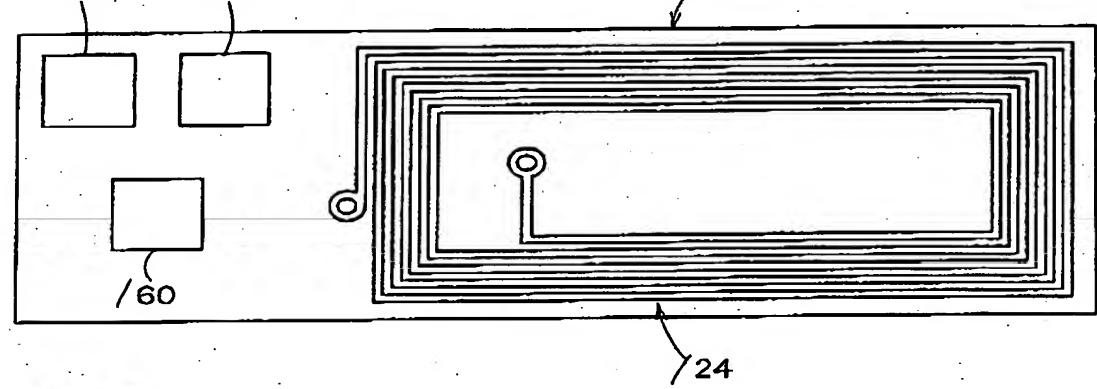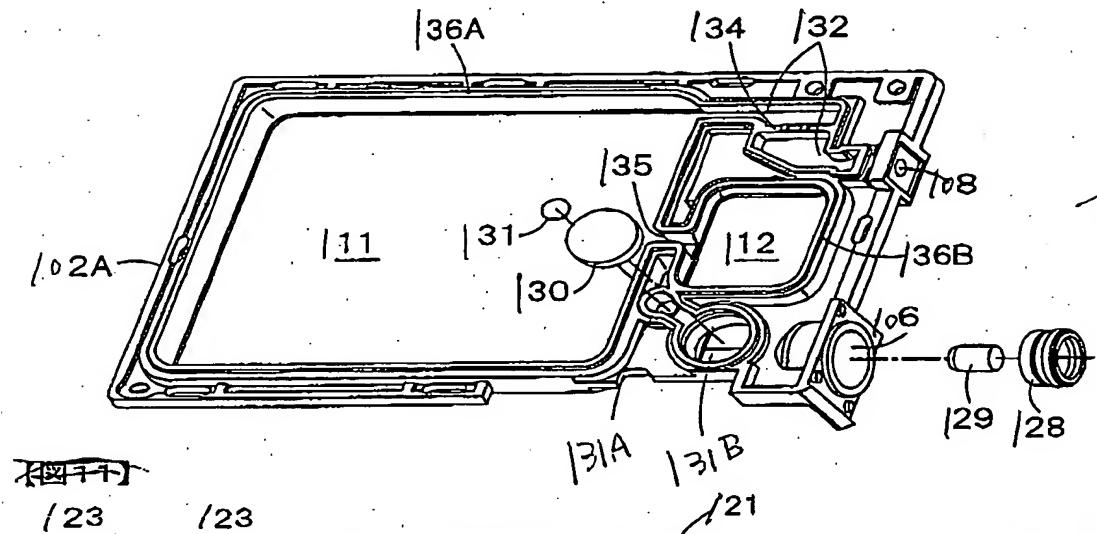

[FIG. 13] >

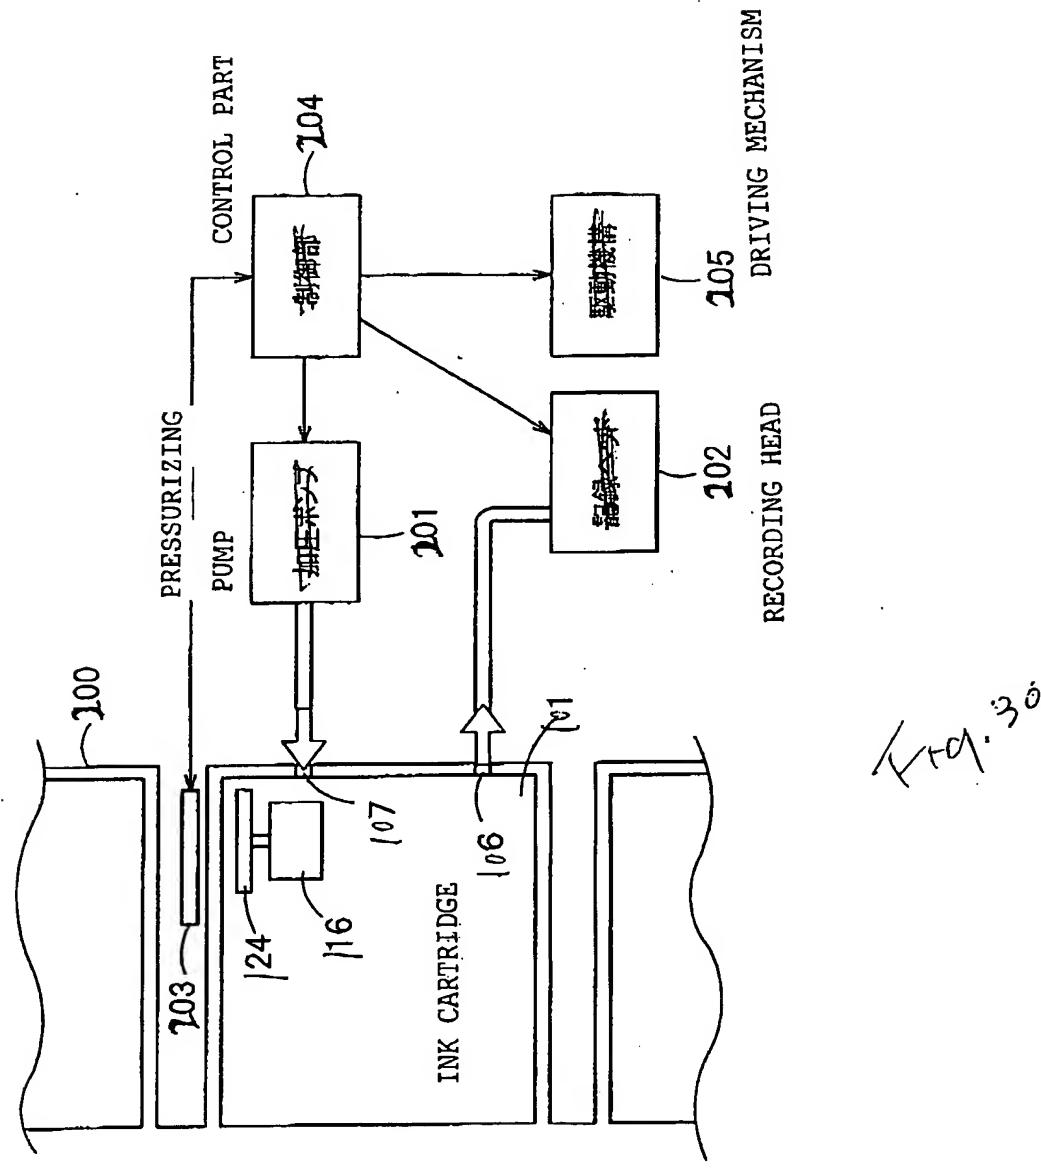


【回路図】

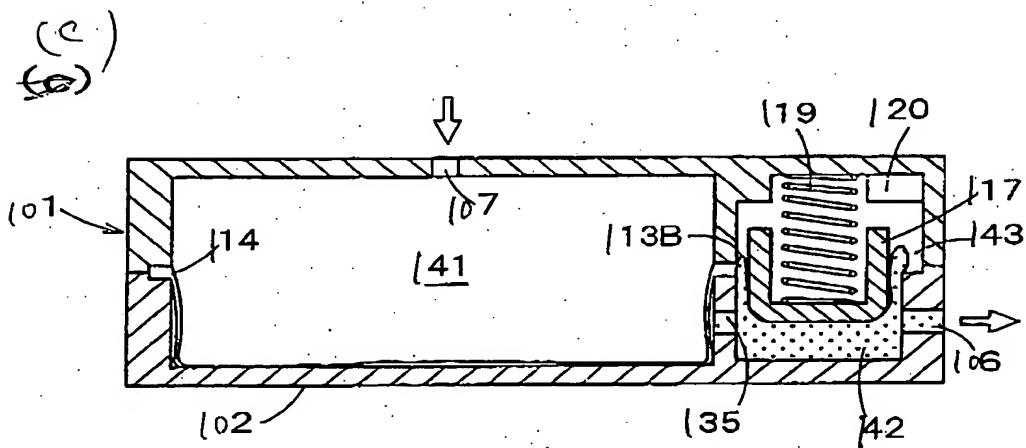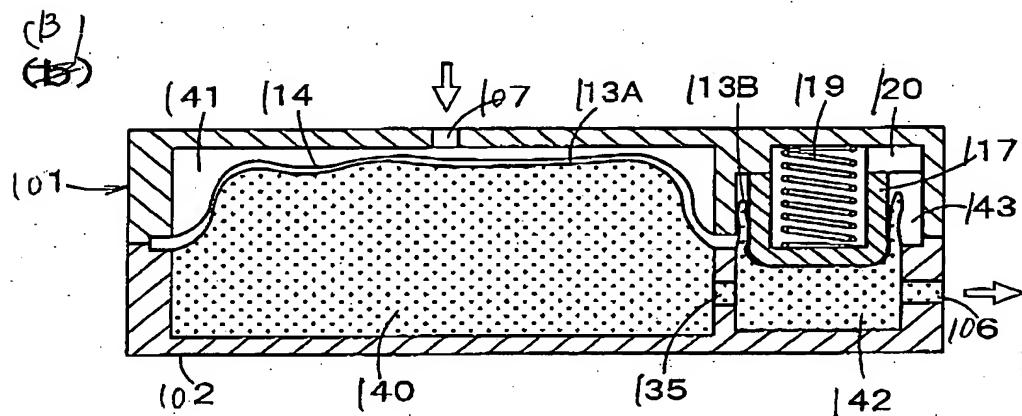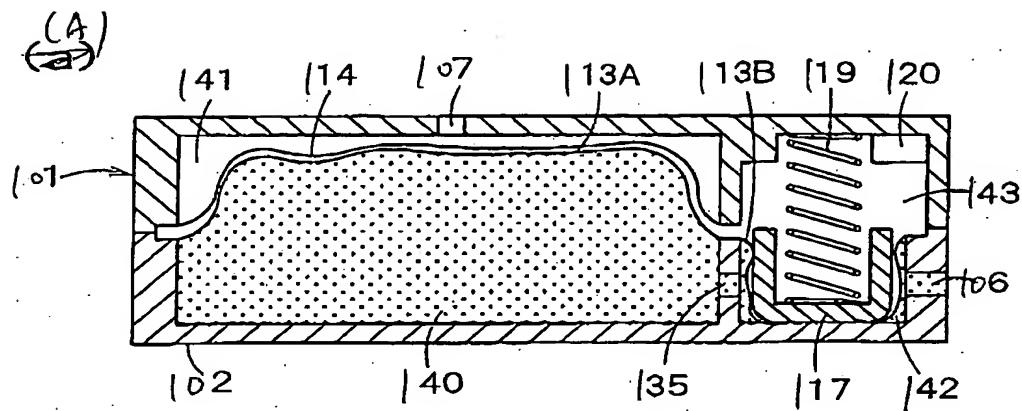

【図15】

Fig. 31

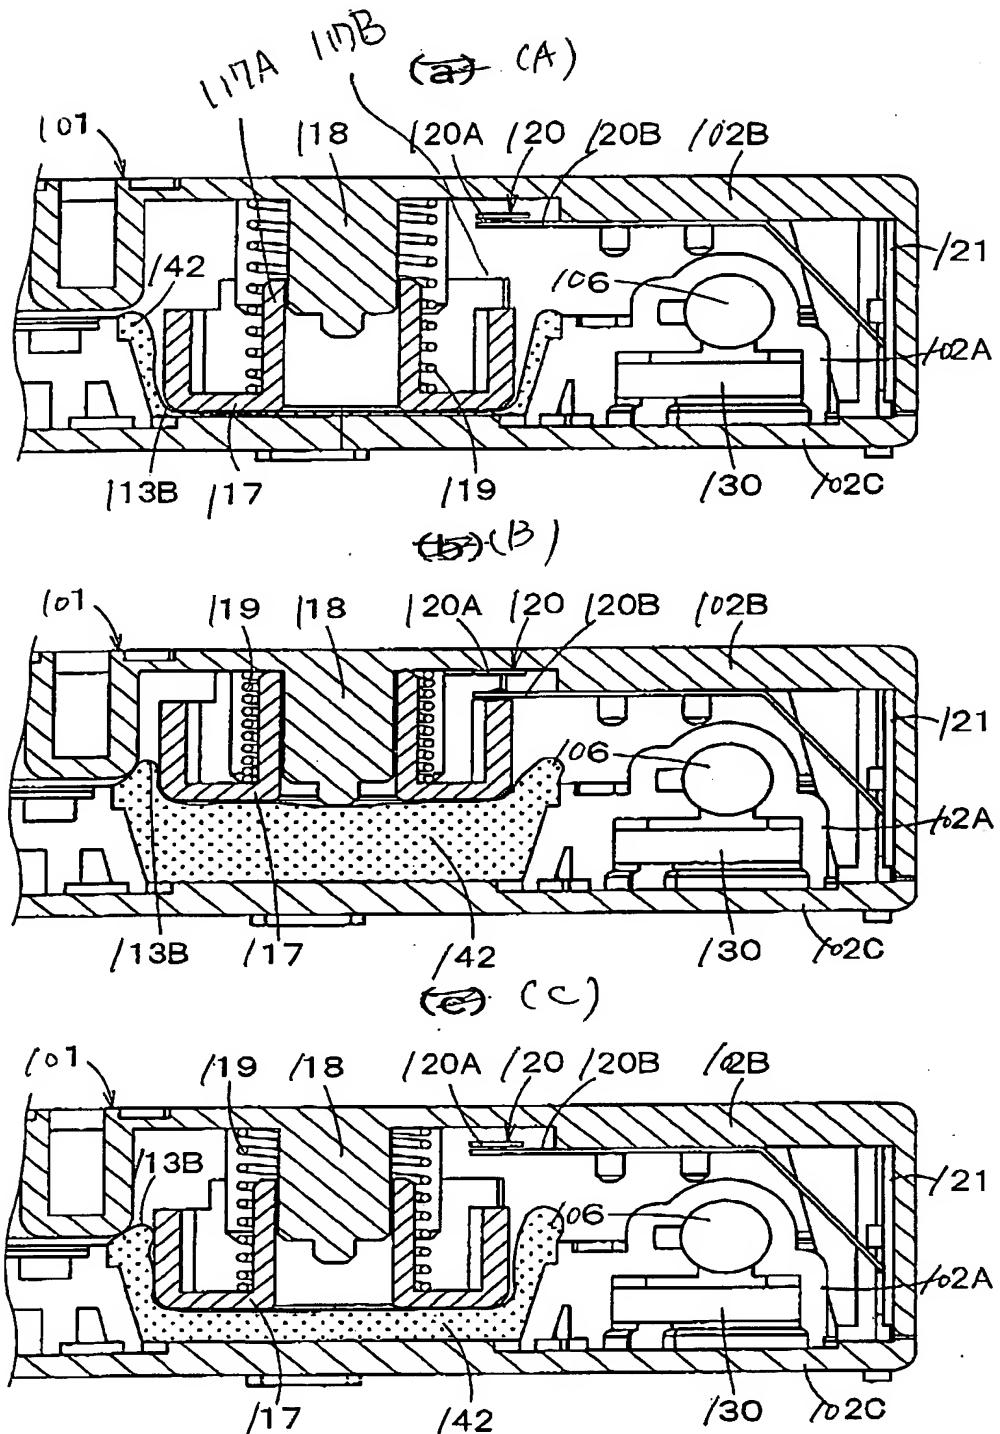


-FIG. 16]

FTG. 32

Inventor: Takahiro Naka, et al.
For: LIQUID CONTAINER
Appln. No.: Not Yet Assigned
Filing Date: Concurrently Herewith (3/26/04)
Atty. Docket: 448563/0245
Sheet No. 25 of 37

STROOCK & STROOCK & LAVAN, LLP
180 Maiden Lane
New York, New York 10038
(212) 806-5400

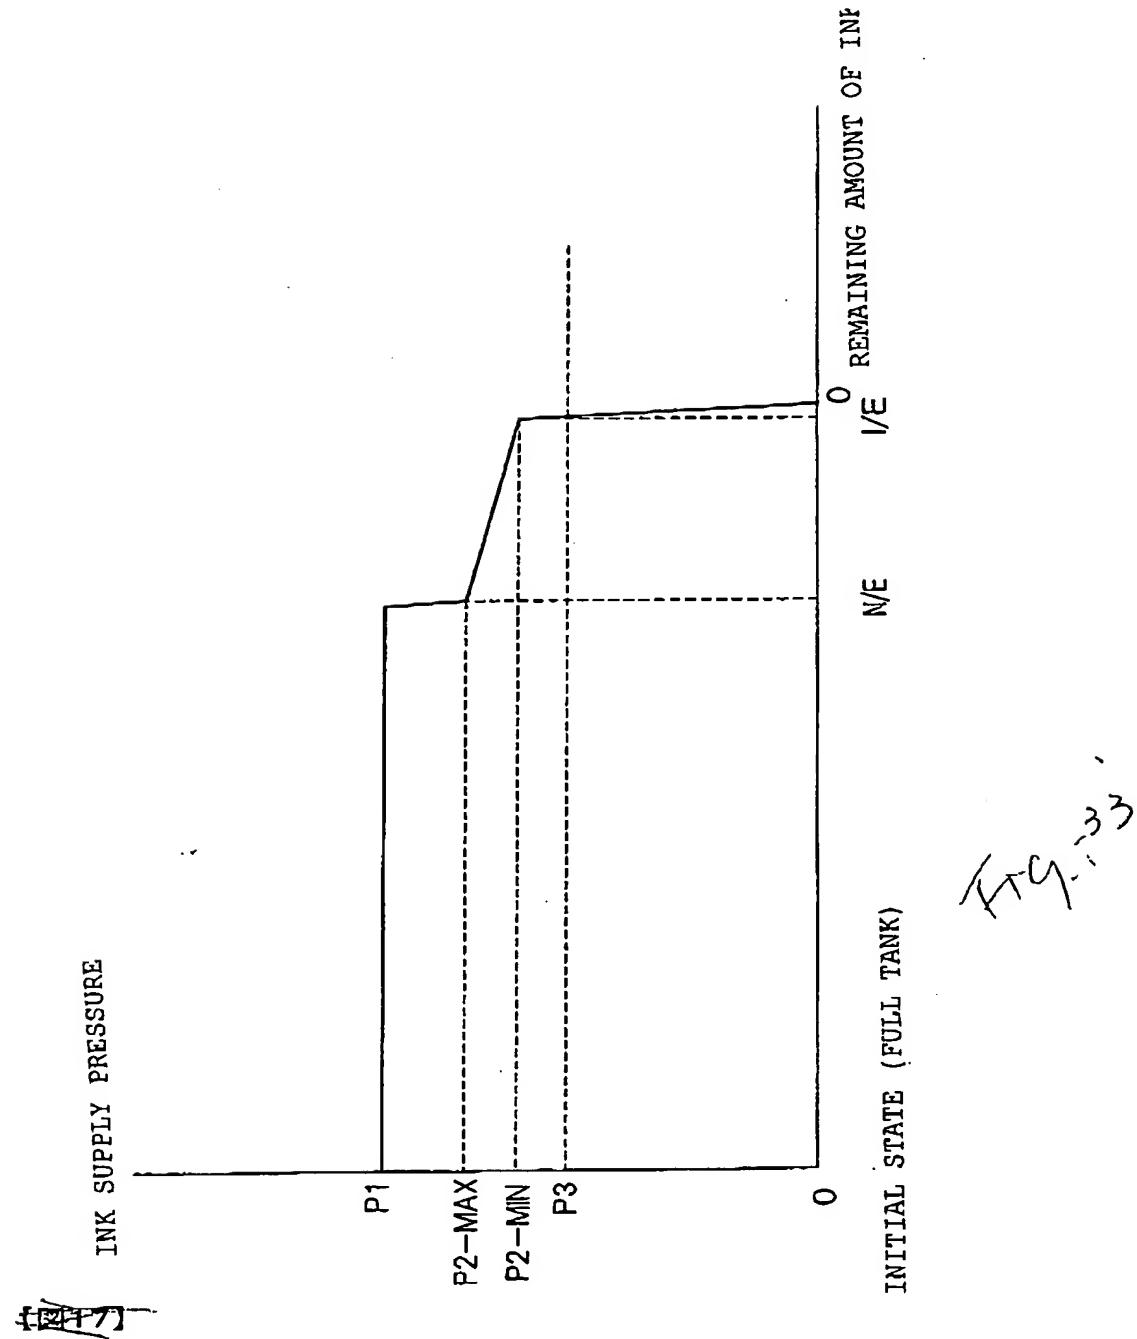

Inventor: Takahiro Naka, et al.
For: LIQUID CONTAINER
Appln. No.: Not Yet Assigned
Filing Date: Concurrently Herewith (3/26/04)
Atty. Docket: 448563/0245
Sheet No. 26 of 37

STROOCK & STROOCK & LAVAN, LLP
180 Maiden Lane
New York, New York 10038
(212) 806-5400

ON/OFF OF DETECTION UNIT		
	THERE IS INK	THERE IS NO INK
OPERATION OF PRESSURIZING OFF PUMP		ON
STOP OF PRESSURIZING PUMP	ON	ON

Fig. 34

"THERE IS INK": THE AMOUNT OF INK IN AN INK RESERVOIR CHAMBER


IS A PREDETERMINED VALUE OR MORE


"THERE IS NO INK": THE REMAINING AMOUNT OF INK IN AN INK RESERVOIR

CHAMBER IS LESS THAN A PREDETERMINED VALUE

Inventor: Takahiro Naka, et al.
For: LIQUID CONTAINER
Appln. No.: Not Yet Assigned
Filing Date: Concurrently Herewith (3/26/04)
Atty. Docket: 448563/0245
Sheet No. 27 of 37

STROOCK & STROOCK & LAVAN, LLP
180 Maiden Lane
New York, New York 10038
(212) 806-5400

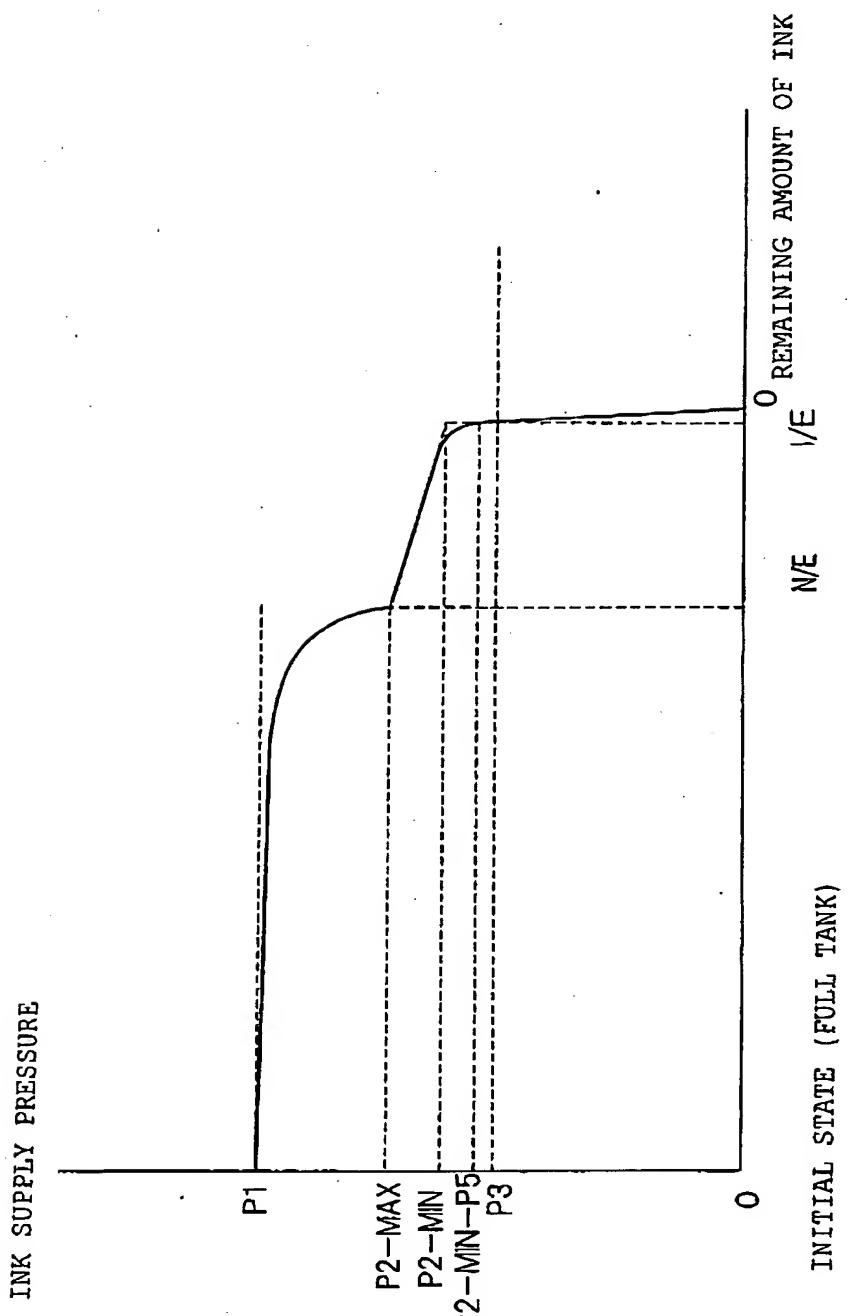

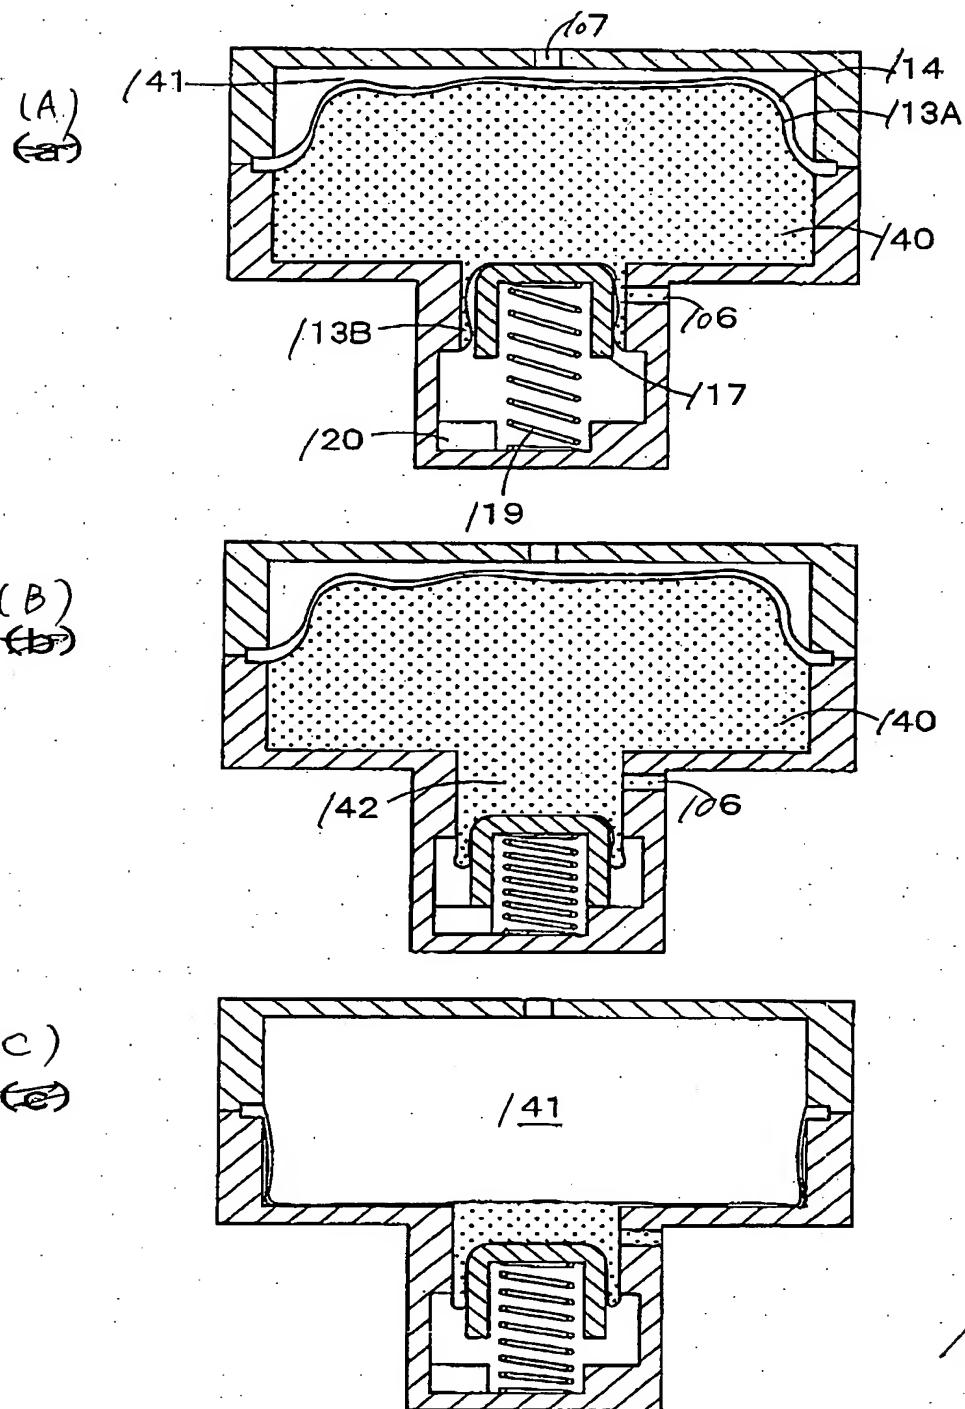

Inventor: Takahiro Naka, et al.
For: LIQUID CONTAINER
Appln. No.: Not Yet Assigned
Filing Date: Concurrently Herewith (3/26/04)
Atty. Docket: 448563/0245
Sheet No. 29 of 37

STROOCK & STROOCK & LAVAN, LLP
180 Maiden Lane
New York, New York 10038
(212) 806-5400




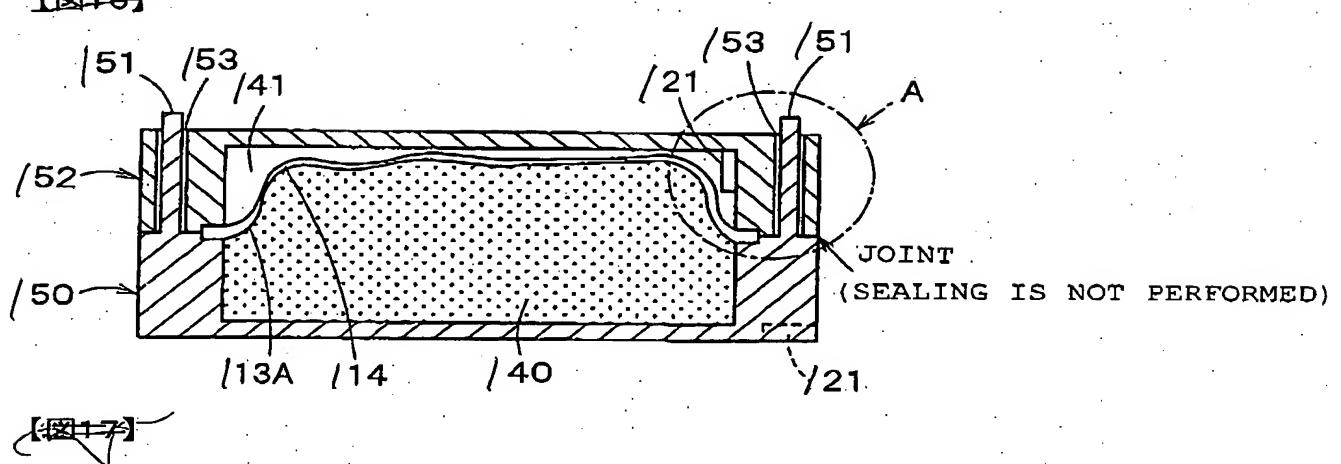


Fig. 37

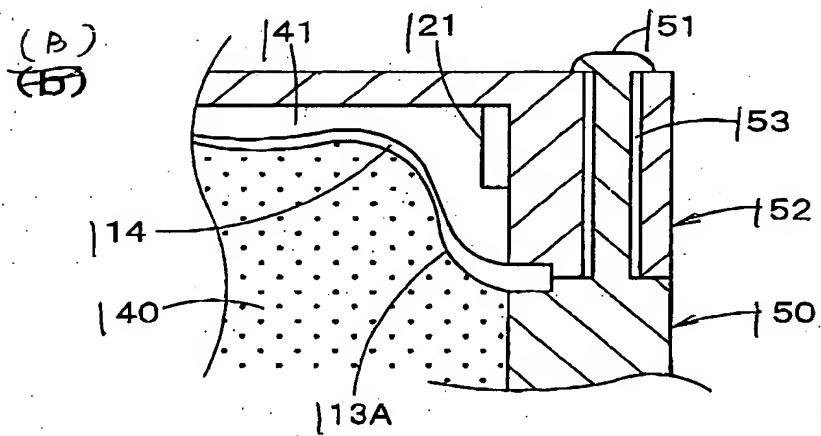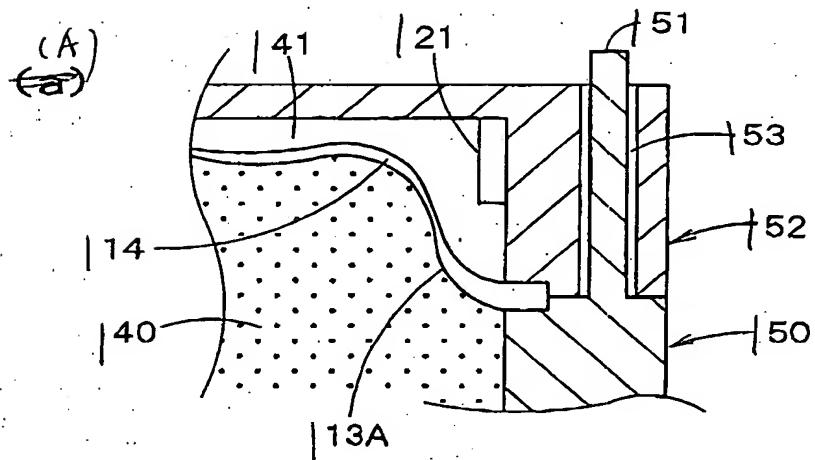

Inventor: Takahiro Naka, et al.
For: LIQUID CONTAINER
Appln. No.: Not Yet Assigned
Filing Date: Concurrently Herewith (3/26/04)
Atty. Docket: 448563/0245
Sheet No. 31 of 37

STROOCK & STROOCK & LAVAN, LLP
180 Maiden Lane
New York, New York 10038
(212) 806-5400

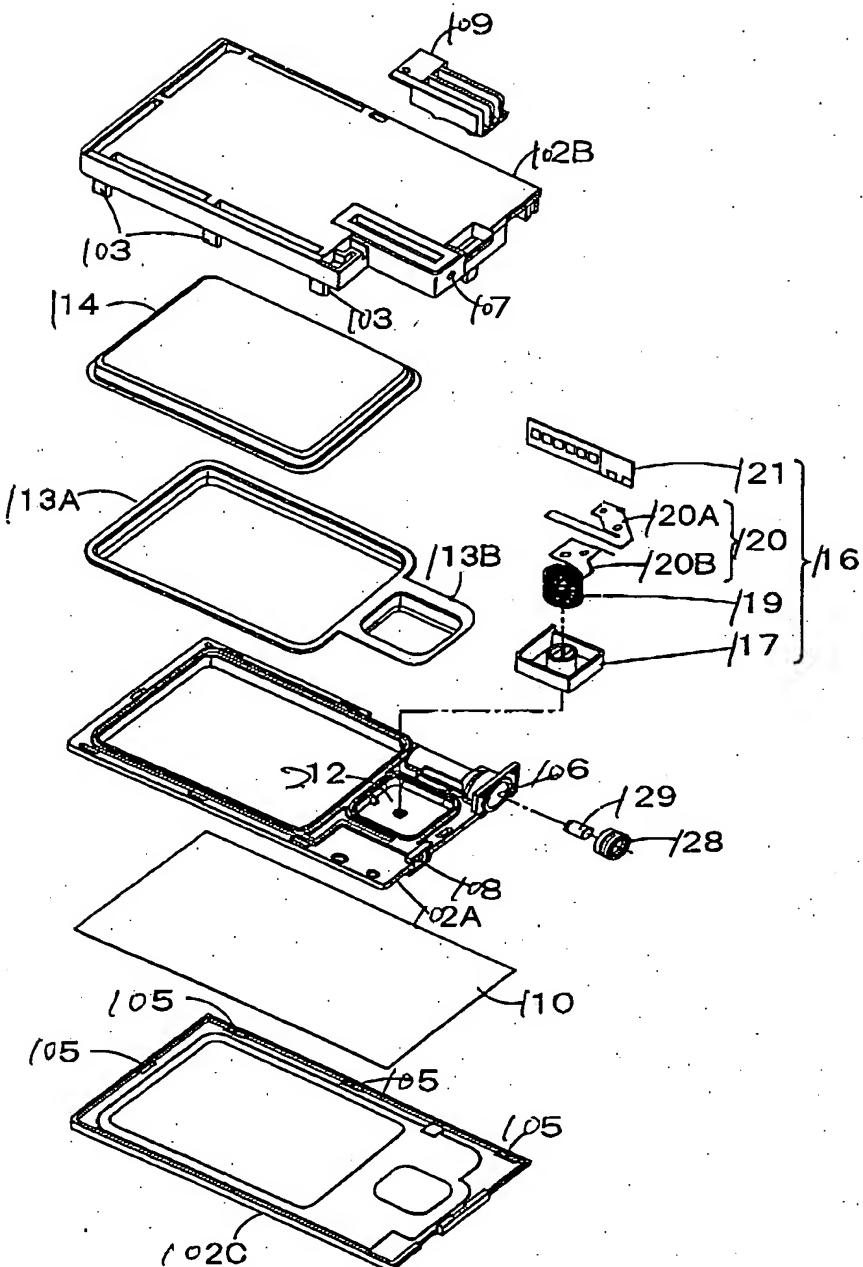


102A

Fig. : 39.


Inventor: Takahiro Naka, et al.
For: LIQUID CONTAINER
Appln. No.: Not Yet Assigned
Filing Date: Concurrently Herewith (3/26/04)
Atty. Docket: 448563/0245
Sheet No. 32 of 37

STROOCK & STROOCK & LAVAN, LLP
180 Maiden Lane
New York, New York 10038
(212) 806-5400

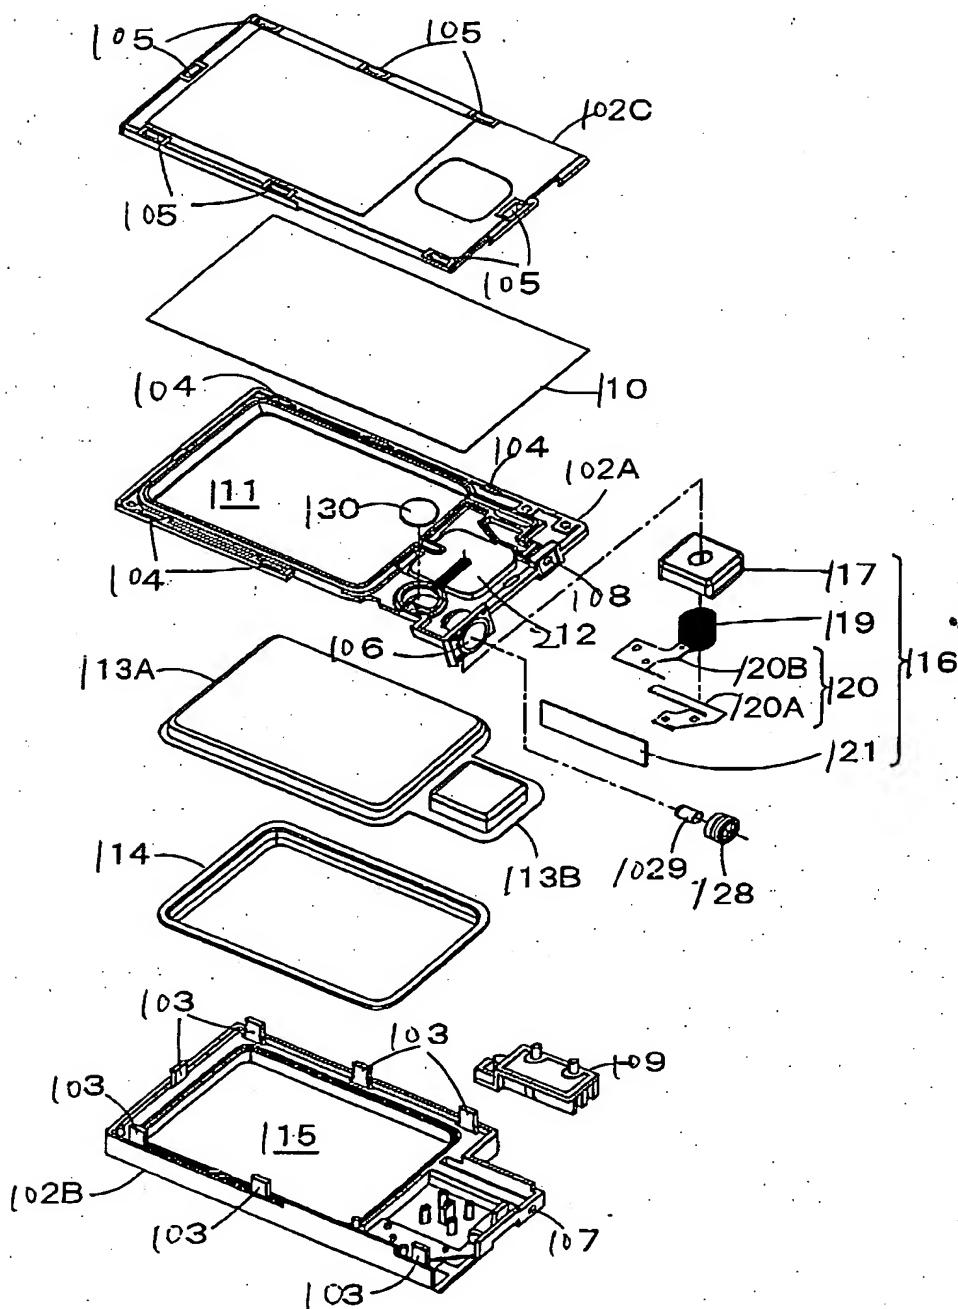




[FIG. 5]

Fig. 40

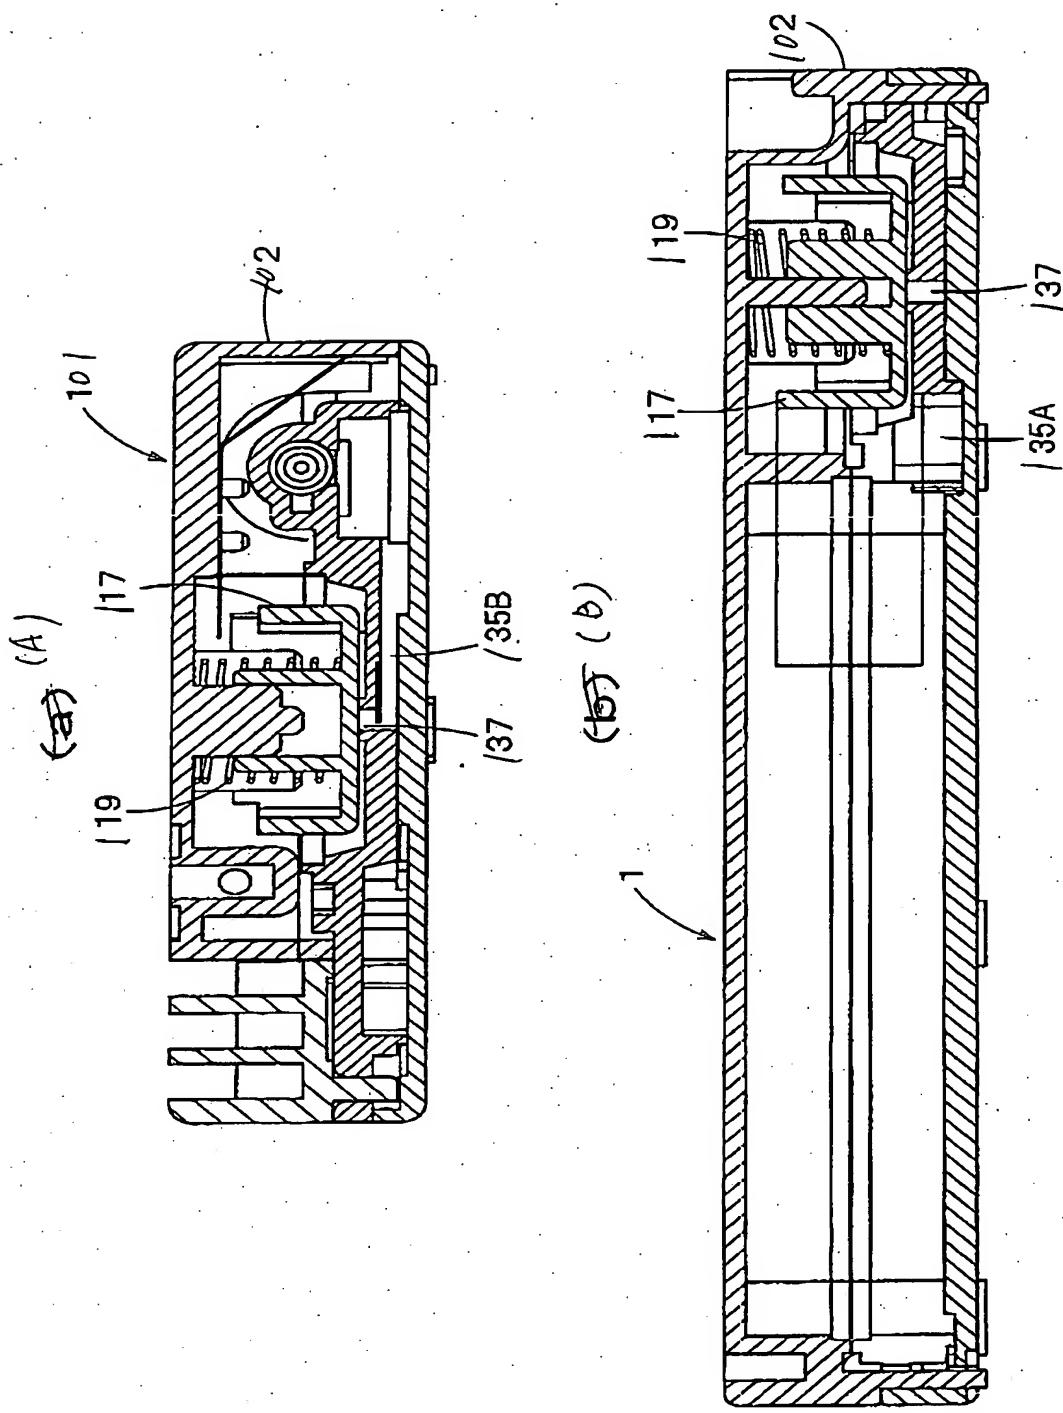


Inventor: Takahiro Naka, et al.
For: LIQUID CONTAINER
Appln. No.: Not Yet Assigned
Filing Date: Concurrently Herewith (3/26/04)
Atty. Docket: 448563/0245
Sheet No. 34 of 37


STROOCK & STROOCK & LAVAN, LLP
180 Maiden Lane
New York, New York 10038
(212) 806-5400

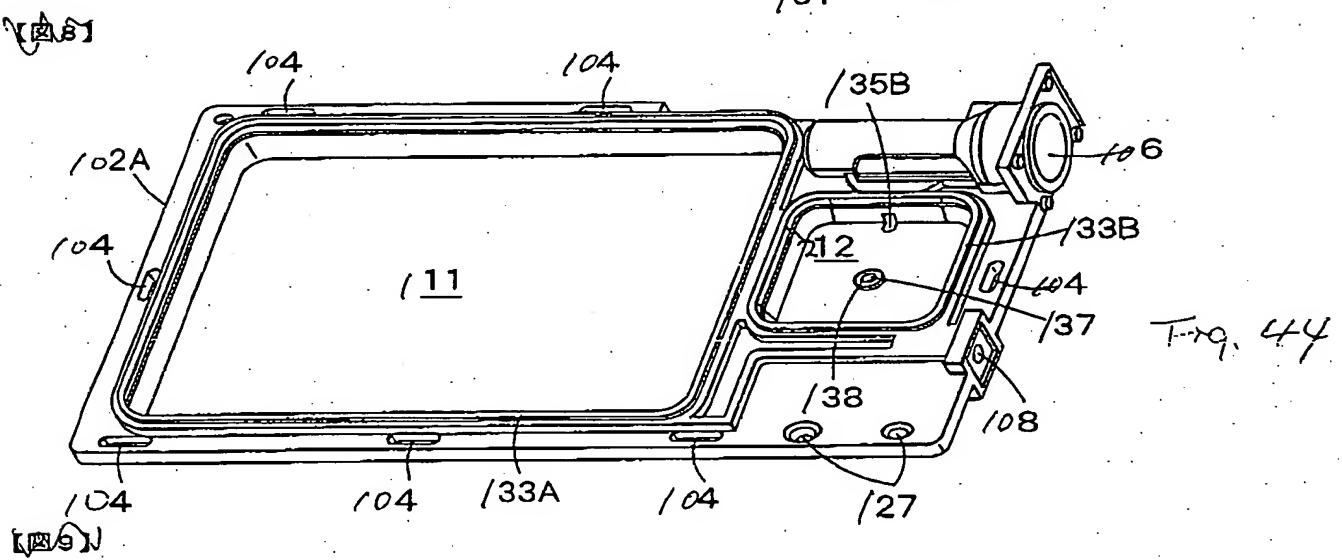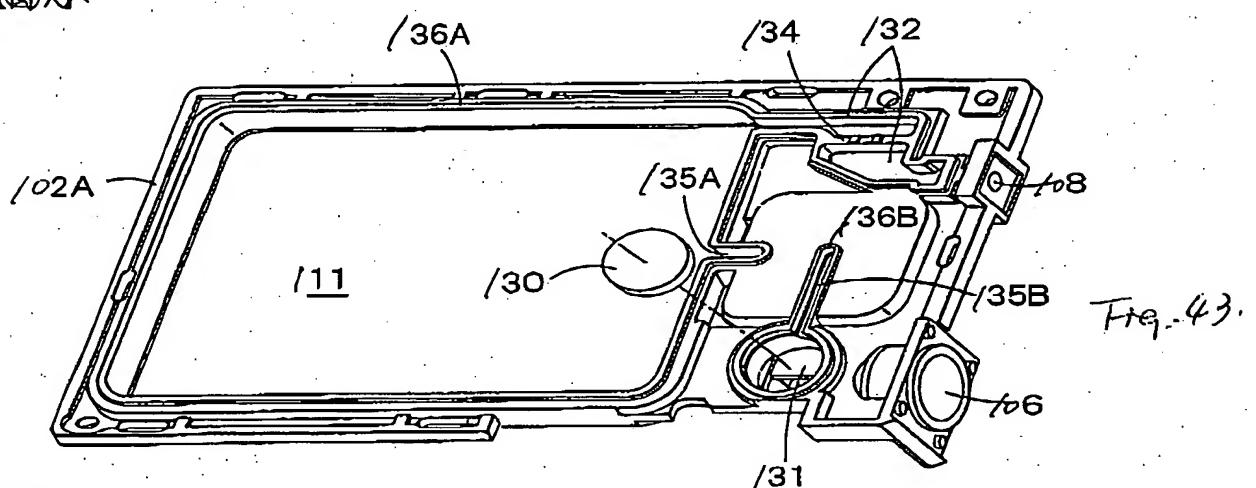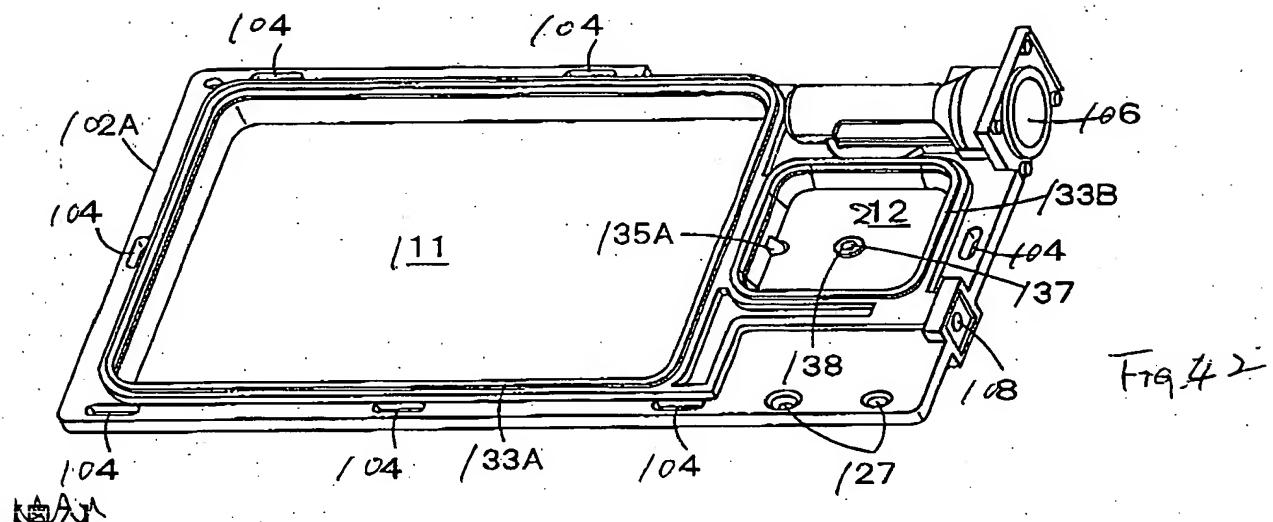

Inventor: Takahiro Naka, et al.
For: LIQUID CONTAINER
Appln. No.: Not Yet Assigned
Filing Date: Concurrently Herewith (3/26/04)
Atty. Docket: 448563/0245
Sheet No. 35 of 37

STROOCK & STROOCK & LAVAN, LLP
180 Maiden Lane
New York, New York 10038
(212) 806-5400

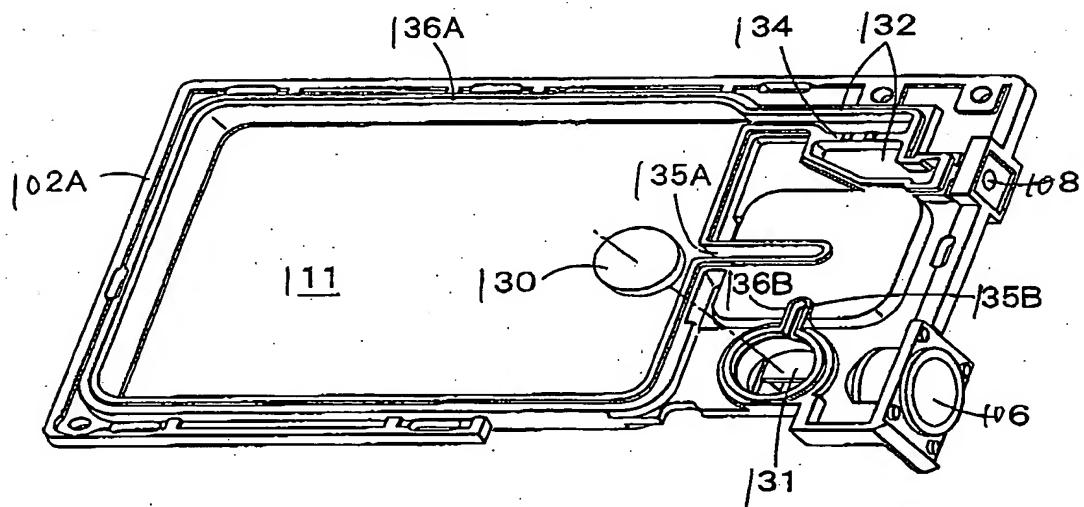

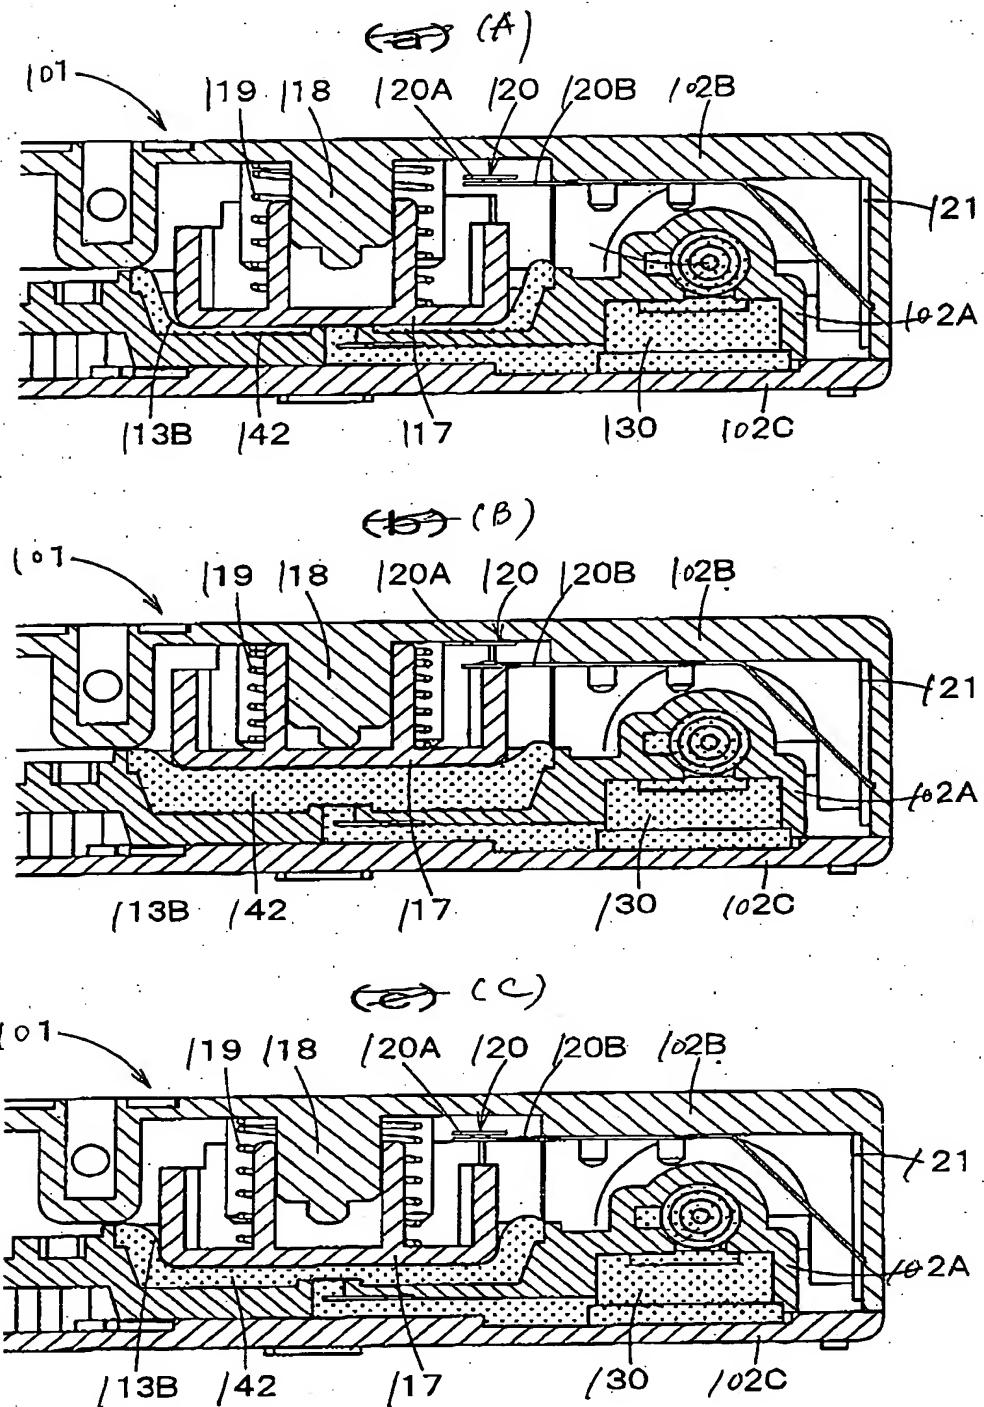


Inventor: Takahiro Naka, et al.
For: LIQUID CONTAINER
Appln. No.: Not Yet Assigned
Filing Date: Concurrently Herewith (3/26/04)
Atty. Docket: 448563/0245
Sheet No. 37 of 37

STROOCK & STROOCK & LAVAN, LLP
180 Maiden Lane
New York, New York 10038
(212) 806-5400

(A)

Fig. 47

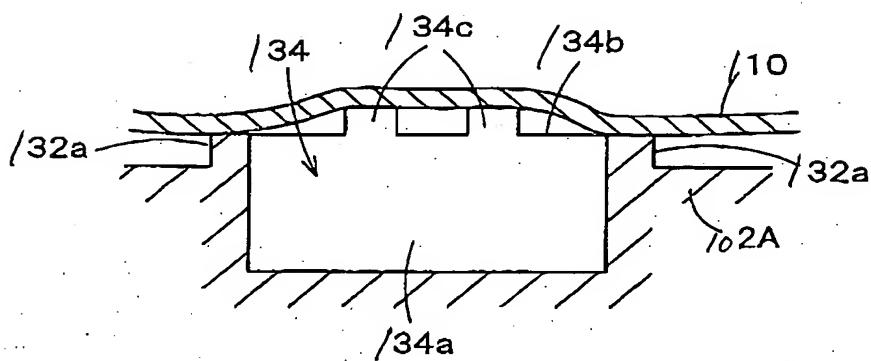

(B)

